

Commonwealth of Virginia  
Uniform Water Well Completion Report

29-70D

Owner Joni & Eugene C English Jr.  
 Address 809 Federal Drive  
Hamlet, Virginia Va. 22405  
 Phone # 391-6233 720-0402 274-5052 Fax 274-5162  
 Location 630 Across from E. English's Garage  
Approx 1 mile off Rt 77 (B&E Courthouse Rd.)

Tax Map ID 28-508  
 VOH Permit SWP-95-17  
 VWCB Permit \_\_\_\_\_  
 VWCB ID \_\_\_\_\_  
 County Stafford  
4/22/95 Rob Snyder

Well Classification IIIA \_\_\_\_\_ IIIB  IIIC \_\_\_\_\_ IV \_\_\_\_\_  
 \* Well Data \*

**General Information**

Drilling Method Air Rotary  
 Depth to Bedrock \_\_\_\_\_  
 Static Water Level Approx 50'  
 Well Disinfected (Y or N) \_\_\_\_\_

Date Completed 2/24/95  
 Yield 25 (GPM)  
 Stabilized Water Level 120  
 Disinfectant Used \_\_\_\_\_

Total Depth of Well 180'  
 Length of Test approx 1 Hr.  
 Natural Flow (Rate) \_\_\_\_\_  
 Amount Used \_\_\_\_\_

**Casing**

From 7' To 63  
 Size 6 1/2 Material P.V.C.  
 Weight/Schedule SDR 27

From 60' To 140'  
 Size 4 Material P.V.C.  
 Weight/Schedule Sch. 40

From 160' To 180'  
 Size 4" Material P.V.C.  
 Weight/Schedule Sch 40

**Gravel Pack**

From \_\_\_\_\_ To \_\_\_\_\_

From \_\_\_\_\_ To \_\_\_\_\_

From \_\_\_\_\_ To \_\_\_\_\_

**Hole size**

10" from 0 to 5 ft.

7 7/8" from 50 to 63 ft.

6 1/8" from 63 to 180 ft.

**Grout**

From 0 To 50+

From \_\_\_\_\_ To \_\_\_\_\_

From \_\_\_\_\_ To \_\_\_\_\_

**Bore Hole Size**

10"

Bore Hole Size \_\_\_\_\_

Bore Hole Size \_\_\_\_\_

**Type**

Groutite

Type \_\_\_\_\_

Type \_\_\_\_\_

**Method**

Pressure Grouting

Method \_\_\_\_\_

Method \_\_\_\_\_

**Water Zones or Screened Intervals**

From 140 To 160

approx water zone  
 From 145 To 155

From \_\_\_\_\_ To \_\_\_\_\_

Mesh Size 1020 Diam 4" (P.V.C.)

Mesh Size \_\_\_\_\_ Diam \_\_\_\_\_

Mesh Size \_\_\_\_\_ Diam \_\_\_\_\_

From \_\_\_\_\_ To \_\_\_\_\_

From \_\_\_\_\_ To \_\_\_\_\_

From \_\_\_\_\_ To \_\_\_\_\_

Mesh Size \_\_\_\_\_ Diam \_\_\_\_\_

Mesh Size \_\_\_\_\_ Diam \_\_\_\_\_

Mesh Size \_\_\_\_\_ Diam \_\_\_\_\_

\* Use Data \*

Private Well: Domestic  Agricultural \_\_\_\_\_ Industrial \_\_\_\_\_ Monitoring \_\_\_\_\_  
 Public Well: Community \_\_\_\_\_ Non Community \_\_\_\_\_

\* Abandonment Information \*

**Bored or Dug Wells**

Casing Removed, Y or N? \_\_\_\_\_  
 If Y, Depth to which casing was removed: \_\_\_\_\_  
 Depth and Type of Fill: \_\_\_\_\_  
 Source of Fill \_\_\_\_\_  
 Bentonite Plugs: From \_\_\_\_\_ to \_\_\_\_\_ From \_\_\_\_\_ to \_\_\_\_\_

**Wells other than Bored Wells**

Casing removed, Y or N? \_\_\_\_\_  
 Depth to which casing was removed: \_\_\_\_\_  
 Applicable, depth(s), and type of gravel/sand fill: \_\_\_\_\_  
 Source of gravel or sand: \_\_\_\_\_  
 Cement: From \_\_\_\_\_ to \_\_\_\_\_ From \_\_\_\_\_ to \_\_\_\_\_


**Method of permanently marking location:**

Installed watertight top  
 Suggest setting pump @ approx. 140 ft. (Well pumped 15 G.P.M. @ 140' on 2/24/95)  
you will encounter 4" casing @ approx 60 ft.  
Suggest keeping longer directors & centralizers out of 4" casing.

Jonis Eugene E. English Jr.

\* Drillers Log \*

Depth	Description of Formation or Sediment	Remarks
0	10	Sandy Red Clay
10	20	Sand & Gravel
20	30	Blue Clay
30	63	Sandy Blue Clay
63	145	Blue Clay
145	155	Grey Sand - Water zone
155	180	Brown Clay

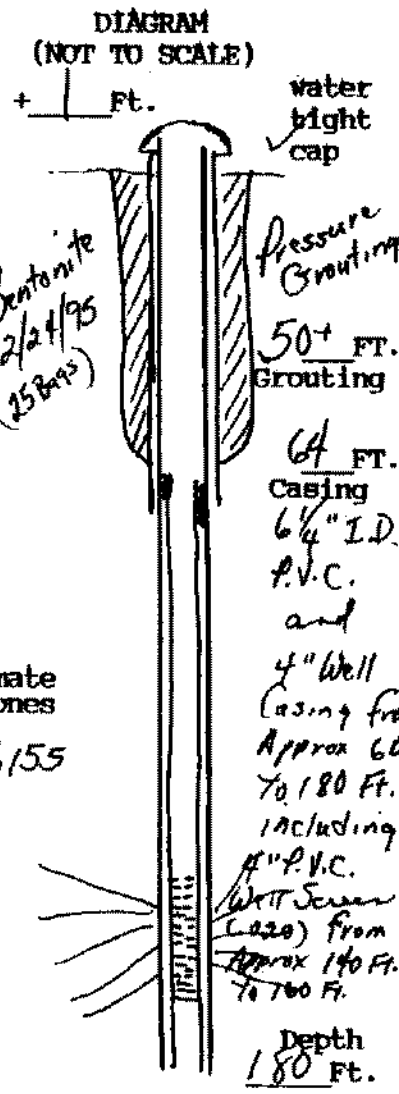

Approximate Water Zones  
145 to 155



(User additional Sheets if necessary)

I certify that the information contained here is true and that this well was installed and constructed in accordance with the permit and further that the well complies with all applicable state and local regulations, ordinances and laws.

Name JOHN L. DANIELSON, JR., INC.  
 Address 4616 HOOD DRIVE  
FREDERICKSBURG, VIRGINIA 22408  
 Phone (703) 898-6025 / 898-9355

Drillers Signature [Signature]  
 Date 2/24/95 Representing JOHN L. DANIELSON, JR., INC.

Virginia Contractors License Number CLASS A 2701 014084A H/H WWC