

Commonwealth of Virginia
Uniform Water Well Completion Report

Owner Carter Bailey / In Sale
Address _____

Tax Map ID 30 N-22
VDH Permit 189-90-37
VWCB Permit _____
VWCB ID _____

Phone _____
Location Cobblestone #22 Stafford 707 / Dent Rd.

County Stafford
3/24/90 Kare Reynolds
3/30/90 R.M. Deal

Well Classification IIIA IIIB IIIC IV
* Well Data *

General Information

Drilling Method Air Rotary
Depth to Bedrock _____
Static Water Level 30
Well Disinfected (Y or N) _____

Date Completed 5/3/93
Yield 30 (GPM)
Stabilized Water Level 80
Disinfectant Used _____

Total Depth of Well 160
Length of Test 1 Hr.
Natural Flow (Rate) _____
Amount Used _____

Casing

From +1 To 91
Size 6 1/4 Material P.V.C.
Weight/Schedule SDR 27

From 80' To 120'
Size 4" Material P.V.C.
Weight/Schedule Sch. 40

From 140' To 160
Size 4" Material P.V.C.
Weight/Schedule Sch. 40

Gravel Pack

From _____ To _____

From _____ To _____

From _____ To _____

Hole size 10 1/8" from 0 to 50 ft.
Grout
From 0 To 50'
Bore Hole Size 10"
Type Bentonite
Method Pressure Grouting

7 1/8" from 50 to 91 ft.
From _____ To _____
Bore Hole Size _____
Type _____
Method _____

6" from 91 to 160 ft.
From _____ To _____
Bore Hole Size _____
Type _____
Method _____

Water Zones or Screened Intervals

From 120 To 170
Mesh Size .020 Diam 8" (P.V.C.)
From _____ To _____
Mesh Size _____ Diam _____

approx water zone
From 125 To 130
Mesh Size _____ Diam _____
From _____ To _____
Mesh Size _____ Diam _____

From _____ To _____
Mesh Size _____ Diam _____
From _____ To _____
Mesh Size _____ Diam _____

*** Use Data ***

Private Well: Domestic Agricultural _____ Industrial _____ Monitoring _____
Public Well: Community _____ Non Community _____

*** Abandonment Information ***

Bored or Dug Wells

Casing Removed, Y or N? _____
If Y, Depth to which casing was removed: _____
Depth and Type of Fill: _____
Source of Fill _____
Bentonite Plugs: From _____ to _____ From _____ to _____

Wells other than Bored Wells

Casing removed, Y or N? _____
Depth to which casing was removed: _____
Applicable, depth(s), and type of gravel/sand fill: _____
Source of gravel or sand: _____
Cement: From _____ to _____ From _____ to _____

Method of permanently marking location: _____


Installed watertight top
Suggest setting pump @ approx. 100 ft.

- You will encounter 4" casing @ approx. 80 Ft.
- Suggest keeping torque correctors & centralizers out of 4" casing.

Carter & Lawyer Bailey
 L & D Homes
 Cobblestone #22
 Stafford #707
 Dent Rd.

* Drillers Log *

Depth	Description of Formation or Sediment	Remarks
0	10	Red Clay
10	30	yellow sand
30	60	Blue Marl
60	91	Sand & Gravel
91	140	Sandstone - water zone
140	160	Blue Clay

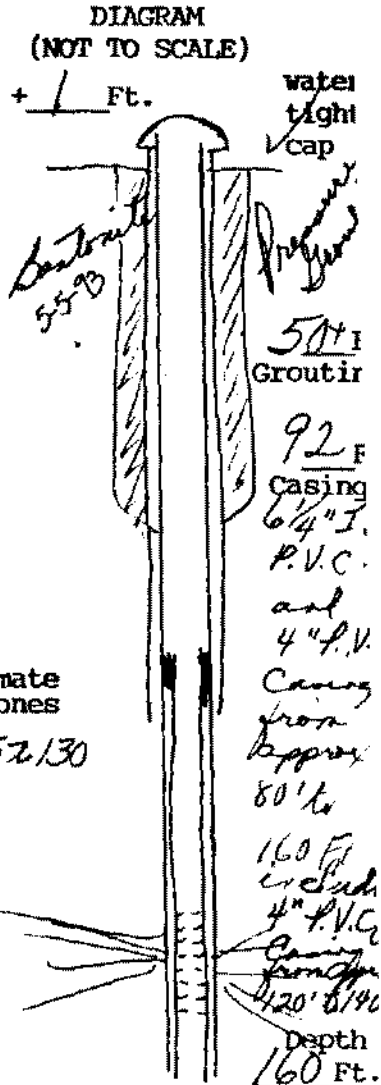

Approximate Water Zones
 125 & 130

(User additional Sheets if necessary)

I certify that the information contained here is true and that this well was installed and constructed in accordance with the permit and further that the well complies with all applicable state and local regulations, ordinances and laws.

Name JOHN L. DANIELSON, JR., INC.
 Address 4616 HOOD DRIVE
FREDERICKSBURG, VIRGINIA 22408
 Phone (703) 898-6025 / 898-9355

Drillers Signature [Signature]
 Date 5/5/93 Representing JOHN L. DANIELSON, JR., INC.

Virginia Contractors License Number CLASS A 2701 014084A H/H WVC