


Owner John Joseph Cunningham
Stafford #131

9. State law requires submitting to the Virginia State Water Control Board information about groundwater and wells for every well intended for water, or any other non-exempt well. This information must be submitted whether the well is completed, on standby. Information required includes an accurately and completely prepared water well completion report, full data from any aquifer pumping cuttings taken at ten foot intervals (unless exemption is secured), the results of any chemical analyses, and copies of any geophysical logs. Pumpage and use reports are required from owners of public supply and industrial wells. County or State permits to drill may be required in some parts of the state. Some counties require submission of a water well completion report. The Virginia State Health Department requires a water well completion report for public supply wells.

10. DRILLERS LOG (use additional Sheets if necessary)

DEPTH (feet)		TYPE OF ROCK OR SOIL (color, material, fossils, hardness, etc.)	REMARKS (water, casing, cavities, broken, core, slugs, etc.)
From	To		
0	20	Hard Red Clay	
20	40	Brown Clay	
40	55	Gray Clay	
55	95	Brown Clay	
95	100	Gray Clay	
100	102	Gray Sand	
102	110	Gray Clay	
110	112	Gray Sand	
112	117	Gray Clay	

Approximate
Water Zones
100-102'
and
110-112'

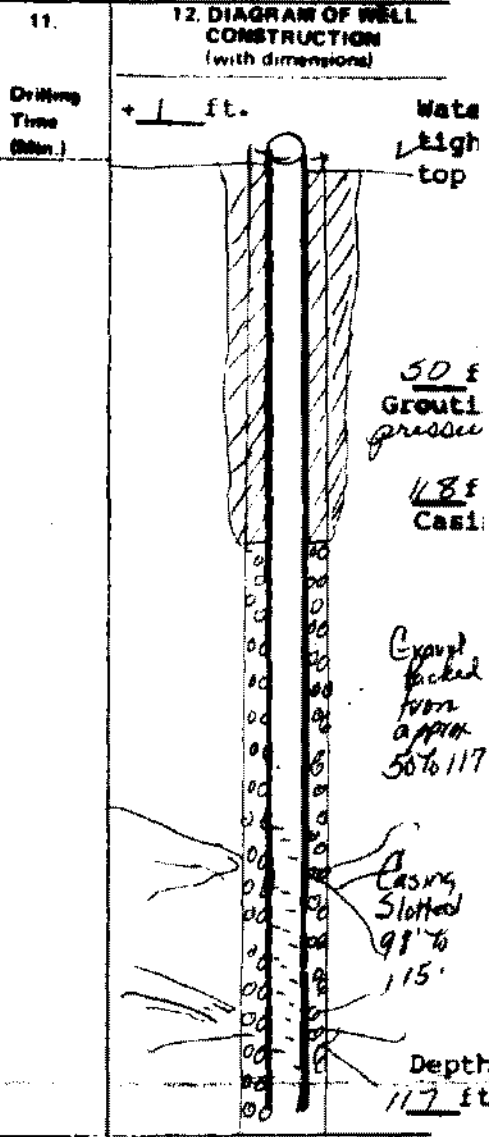

13. Well lot dedicated? _____ Size _____ ft. X _____ ft., Well house? _____
Distance to nearest pollutant source _____ ft., Type _____
Distance to nearest property line _____ ft., Building _____ ft.

14. WATER SERVICE PIPE: Checked under _____ p.s.i. for _____ minutes. Pipe size _____ inches, Material _____
Installer _____
Date _____

15. I certify that the information contained herein is true and correct and that this well and/or system has been installed and constructed in accordance with the requirements for well construction as specified in compliance with appropriate county or independent city ordinances and the laws and rules of the Commonwealth of Virginia.

- State Water Control Board Regional Offices**
- Valley Reg. Off.
6 North Main Street
O. Box 268
Bridgewater, Va. 22812
703-828-2595
 - West Reg. Off.
1 East Main Street
O. Box 476
Bedon, Va. 24010
628-5183
 - East Central Reg. Off.
Executive Park
5312 Peters Creek Road
Roanoke, Va. 24019
708-982-7452
 - Piedmont Reg. Off.
4010 West Broad Street
P. O. Box 6616
Richmond, Va. 23210
804-257-1006
 - Tidewater Reg. Off.
287 Pembroke Office Park
Suite 310 Pembroke No. 2
Va. Beach, Va. 23462
804-499-8742
 - Northern Virginia Reg. Off.
5515 Chesapeake Avenue
Suite 404
Alexandria, Va. 22312
703-750-9111

Signature Russ T. Danielson (Well driller or authorized person), Date 9/19/85
License No. _____