

COMMONWEALTH OF VIRGINIA
WATER WELL COMPLETION REPORT

BWCM No. _____

(Certification of Completion/County Permit)

Boyle Builders
2123 W. Dancy Highway
Stafford, Va 22554
659-1063

Control Board
1143
Hamilton St.
Va. 23230

County/City Stafford

County/City Stamp

Virginia Plane Coordinates

N _____
E _____

Latitude & Longitude
N _____
W _____

Topo. Map No. 182A

Elevation _____ ft

Formation _____

Lithology _____

River Basin _____

Province _____

Type Logs D. L.

Cuttings N. A.

Water Analysis _____

Aquifer Test _____

Owner For Sale

Well Designation or Number _____

Address _____

Phone _____

Drilling Contractor John L. Danielson, Jr., Inc.

Address 4616 Hood Drive
Fredericksburg, Virginia 22401

Phone (703) 898-6025

SWCB Permit _____

County Permit SD 87-61

Certification of inspecting official:
This well does _____ does not _____
meet code/low requirements.
S. _____
Date _____

For Office Use

SD-87-68 *Frank T. Dwyer*
2-23-87

Tax Map I.D. No. 7-30-143-E

Subdivision Woodruff

Section _____

Block _____

Lot #4

Class Well I _____ II A _____
II B _____ III A _____ III B
III C _____ III D _____ III F _____

WELL LOCATION: 1 1/2 (feet/miles) W. (direction) of intersection of 630 & 1
and 3/10 feet/miles S (direction) of #630

(If possible please include map showing location marked)

Date started 6/24/87 Water rose 5 ft. in 30 min. @ time of installation.
24" I.D. casing holds 23.5 gal. of water per foot.

Date completed 6/28/87 Type rig Boring Rig

Approximate Drawdown 15 ft.

WELL DATA: New Reworked _____ Deepened _____

Total depth 61 ft.

Depth to bedrock _____ ft.

Hole size (Also include reamed zones)

39 inches from 0 to 29 ft.

29 inches from 20 to 61 ft.

Casing size (I.D.) and material

24 inches from +1 to 61 ft.

Material Concrete Casing

Wt. per foot _____ or wall thickness _____ in.

Screen size and mesh for each zone (where applicable)

Gravel pack

Grout

2. WATER DATA • Water temperature _____ of _____

• Static water level (unpumped level-measured) 25 ft.

• Stabilized measured pumping water level 40 ft.

• Stabilized yield 2.5 gpm after 2 hours of operation

Natural Flow: Yes _____ No flow rate _____ gpm

Comment on quality _____

3. WATER ZONES: From 25 To 35

From 35 To 45 From _____ To _____

From _____ To _____ From _____ To _____

4. USE DATA

Type of use: Drinking Livestock Watering _____

Irrigation _____ Food processing _____ Household _____

Manufacturing _____ Fire safety _____ Cleaning _____

Recreation _____ Aesthetic _____ Cooling or heating _____

Injection _____ Other _____

• Type of facility: Domestic Public water supply _____

Public institution _____ Farm _____ Industry _____

Commercial _____ Other _____

5. PUMP DATA: Type _____ • Rated H.P. _____

• Intake depth _____ • Capacity _____ at _____ head

6. WELLHEAD: Type well seal _____

Pressure tank _____ gal. Loc. _____

Sample tap _____ Measurement port _____

Well vent _____ Pressure relief valve _____

Gate valve _____ Check valve (when required) _____

Electrical disconnect switch on power supply _____

7. DISINFECTION: Well disinfected _____ yes _____ no _____

Date _____ Disinfectant used _____

Amount _____ Hours used _____

8. ABANDONMENT (where applicable) • yes _____ no _____


Casing pulled yes _____ no _____ not applicable _____

Plugging grout From _____ to _____ material _____

Pump installation through Case Bedrock

Frank Beckfield, Staunton

W. L. DANIELSON, JR., INC.
Drilled & Bored Wells
4616 Hood Drive
FREDERICKSBURG, VIRGINIA 22401

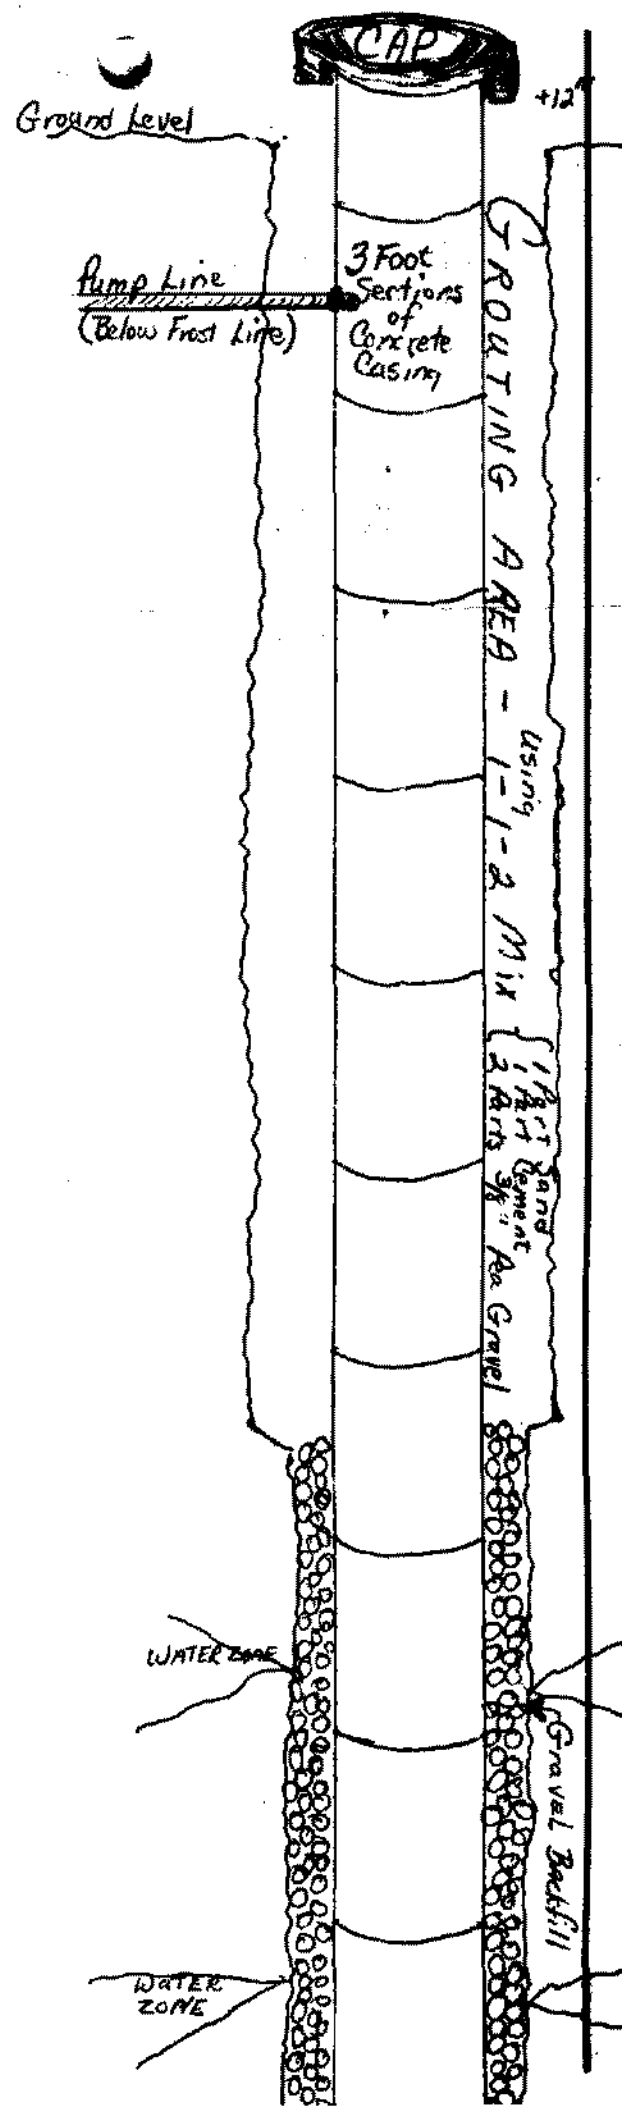

Phone 898-WELL or 898-6025