

Barbara Gullledge
United Land & Marine Services, Inc.
24 Mountain Laurel Court
Fredericksburg, VA 22406
752-4931

Commonwealth of Virginia

Uniform Water Well Completion Report

Owner John & Barbara Gullledge
Address 276 MacGregor Ridge Road

Tax Map ID 30D-17R
VDH Permit SWT-95-129
VWCB Permit _____
VWCB ID _____
County Stafford

Phone # 752-4931
Location MacGregor Ex 17R MacGregor Ridge Rd

Well Classification IIIA IIIB IIIC IV
* Well Data *

SFF

General Information

Drilling Method Rotary
Depth to Bedrock _____
Static Water Level 20'
Well Disinfected (Y or N) _____

Date Completed 9/5/95
Yield 30 (GPM)
Stabilized Water Level approx 40'
Disinfectant Used _____

Total Depth of Well 120
Length of Test approx 1 Hr.
Natural Flow (Rate) _____
Amount Used _____

Casing

From 7 1/2' To 68'
Size 6 1/4" Material P.V.C.
Weight/Schedule SDR 27

From 60' To 100'
Size 4" Material P.V.C.
Weight/Schedule Sch 40

From _____ To _____
Size _____ Material _____
Weight/Schedule _____

Gravel Pack

From _____ To _____

From _____ To _____

From _____ To _____

Hole size

10" from 0 to 50 ft.

7 7/8" from 50 to 68 ft.

6" from 68 to 120 ft.

From 0 To 50'

From _____ To _____

From _____ To _____

Bore Hole Size 10"

Bore Hole Size _____

Bore Hole Size _____

Type Bentonite

Type _____

Type _____

Method Pressure Grouting

Method _____

Method _____

Water Zones or Screened Intervals

From 100 To 120

approx water zone
From 101 To 117

From _____ To _____

Mesh Size 20 Diam 4" (P.V.C.)

Mesh Size _____ Diam _____

Mesh Size _____ Diam _____

From _____ To _____

From _____ To _____

From _____ To _____

Mesh Size _____ Diam _____

Mesh Size _____ Diam _____

Mesh Size _____ Diam _____

* Use Data *

Private Well: Domestic
Public Well: Community _____

Agricultural _____ Industrial _____ Monitoring _____
Non Community _____

* Abandonment Information *

Bored or Dug Wells

Casing Removed, Y or N? _____
If Y, Depth to which casing was removed: _____
Depth and Type of Fill: _____
Source of Fill _____
Bentonite Plugs: From _____ to _____ From _____ to _____

Wells other than Bored Wells

Casing removed, Y or N? _____
Depth to which casing was removed: _____
Applicable, depth(s), and type of gravel/sand fill: _____
Source of gravel or sand: _____
Cement: From _____ to _____ From _____ to _____

Method of permanently marking location: _____


Installed watertight top
Suggest setting pump @ approx. 60 ft.

*You will encounter 4" casing @ approx 60'
Suggest keeping centralizers & tongue arrestors out of
4" casing*

Guilledge
Mac Gregor #17R
Stafford
McCGregor Ridge Rd.

• Drillers Log •

Depth	Description of Formation or Sediment	Remarks
0	5	Sandy Red Clay
5	17	Sand & Gravel
17	68	Grey Sandy clay
68	101	Brown clay
101	117	Grey clay
117	120	Brown clay

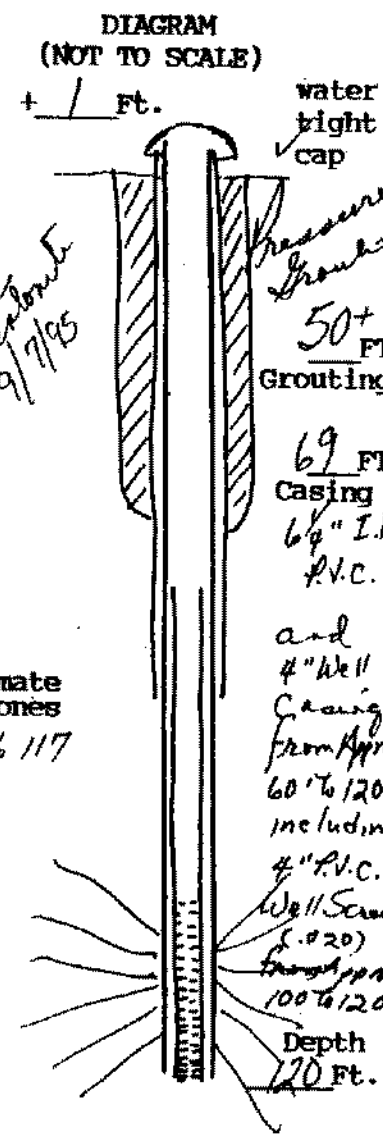

Approximate Water Zones
 101 to 117

(User additional Sheets if necessary)

I certify that the information contained here is true and that this well was installed and constructed in accordance with the permit and further that the well complies with all applicable state and local regulations, ordinances and laws.

Name JOHN L. DANIELSON, JR., INC.
 Address 4616 HOOD DRIVE
FREDERICKSBURG, VIRGINIA 22408
 Phone (703) 898-6025 / 898-9355
 Drillers Signature John L. Danielson, Pres.
 Date 9/7/95 Representing JOHN L. DANIELSON, JR., INC.
 Virginia Contractors License Number CLASS A 2701 014084A H/H WWC