

Best 370-5211
Dayer

Commonwealth of Virginia
Uniform Water Well Completion Report

Best Study

Owner Duane La Fratte
Address 208 Beacon Cove
Stafford Co. 22554
Phone 1659-9535
Location Stafford Wayside 1 1/2 mi² from 630 on right
Well Classification IIIA IIIB IIIC IV
* Well Data *

Tax Map ID 30-118
VDH Permit W-97-189
VWCB Permit _____
VWCB ID _____
County Stafford
4/3/97 Kit Simpson
SFF

General Information
Drilling Method Air Rotary
Depth to Bedrock _____
Static Water Level 60'
Well Disinfected (Y or N) _____

Date Completed 6/26/97
Yield 20 (GPM)
Stabilized Water Level Approx 60'
Disinfectant Used _____

Total Depth of Well 200
Length of Test approx 1 Hr.
Natural Flow (Rate) _____
Amount Used _____

Casing
From 1 To 66
Size 6 1/4 Material P.V.C.
Weight/Schedule S.D.R 27

From 60 To 160
Size 4" Material P.V.C.
Weight/Schedule Sch 40

From 180 To 200
Size 4" Material P.V.C.
Weight/Schedule Sch 40

Gravel Pack
From _____ To _____
Hole size 10" from 0 to 60 ft.
Grout
From 0 To 50'
Bore Hole Size 10" 6/23/97
Type Bentonite
Method Treasure Shovel

From _____ To _____
Hole size 7 7/8" from 60 to 66 ft.
From _____ To _____
Bore Hole Size _____
Type _____
Method _____

From _____ To _____
Hole size 6 1/2" from 66 to 200 ft.
From _____ To _____
Bore Hole Size _____
Type _____
Method _____

Water Zones or Screened Intervals
From 160 To 180
Mesh Size .020 Diam 4" (P.V.C.)
From _____ To _____
Mesh Size _____ Diam _____

approx water zone
From 165 To 175
Mesh Size _____ Diam _____
From _____ To _____
Mesh Size _____ Diam _____

From _____ To _____
Mesh Size _____ Diam _____
From _____ To _____
Mesh Size _____ Diam _____

* Use Data *

Private Well: Domestic Agricultural _____ Industrial _____ Monitoring _____
Public Well: Community _____ Non Community _____

* Abandonment Information *

Bored or Dug Wells
Casing Removed, Y or N? _____
If Y, Depth to which casing was removed: _____
Depth and Type of Fill: _____
Source of Fill _____
Bentonite Plugs: From _____ to _____ From _____ to _____

Wells other than Bored Wells
Casing removed, Y or N? _____
Depth to which casing was removed: _____
Applicable, depth(s), and type of gravel/sand fill: _____
Source of gravel or sand: _____
Cement: From _____ to _____ From _____ to _____

Method of permanently marking location:
 Installed watertight top
Suggest setting pump @ approx. 150 ft.
You will encounter 4" casing @ approx 60 ft.
Suggest keeping centralizers & torque arrestors out of 4" casing

Base Sheet:


Deann La Pratte

4.5. #1 (Way Side) approx 1 mile from 630 - on Right

Stafford

* Drillers Log *

Depth	Description of Formation or Sediment	Remarks
0	10	Red Clay
10	20	Sand & Gravel
20	66	Blue Clay
66	165	Brown Clay
165	175	Grey Sand - water zone
175	200	Blue Clay

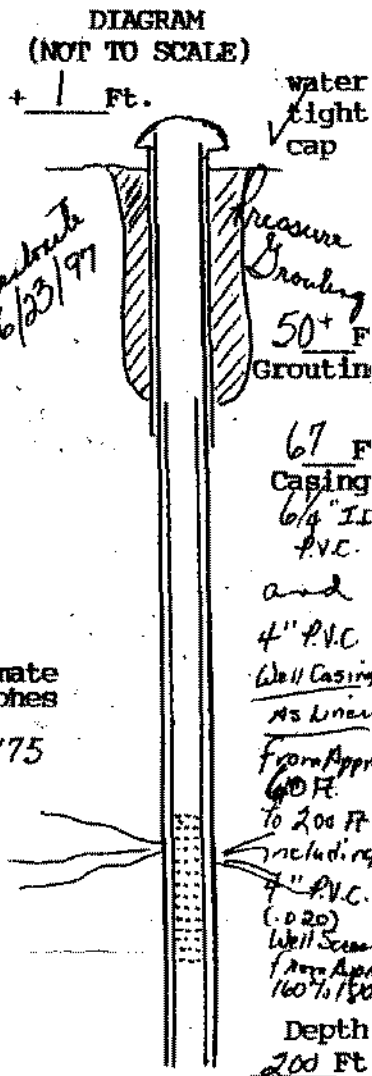

(User additional Sheets if necessary) //

I certify that the information contained here is true and that this well was installed and constructed in accordance with the permit and further that the well complies with all applicable state and local regulations, ordinances and laws.

Name JOHN L. DANIELSON, JR., INC.
 Address 4616 HOOD DRIVE
FREDERICKSBURG, VIRGINIA 22408
 Phone 540 (203) 898-6025 / 898-9355

Drillers Signature Rosa T. Danielson, President
 Date 6/23/97 Representing JOHN L. DANIELSON, JR., INC.

Virginia Contractors License Number CLASS A 2701 014084A H/H WVC