

Agitation Home Builders  
P.O. Box 840  
Harrisonville, Va. 22463  
659-1113

Commonwealth of Virginia  
Uniform Water Well Completion Report

Owner Agitation Home Builders  
Address P.O. Box 840  
Harrisonville, Va. 22463  
Phone 659-1113  
Location Quarry Rd.  
Decorative Rd. → L. on Brentwood Rd. → R. on Quarry Rd. 4/21/96 Daniel J. Joady  
Well Classification IIIA IIIB  IIIC IV Ground Access Rd.

Tax Map ID 31-56  
VDH Permit SWP-96-119  
VWCB Permit \_\_\_\_\_  
VWCB ID \_\_\_\_\_  
County Stafford  
\* Well Data \* PGI

General Information

Drilling Method Mud Rotary  
Depth to Bedrock \_\_\_\_\_  
Static Water Level 140  
Well Disinfected (Y or N) \_\_\_\_\_

Date Completed 7/25/96  
Yield 20 (GPM)  
Stabilized Water Level 20  
Disinfectant Used \_\_\_\_\_

Total Depth of Well 265  
Length of Test Approx 2 Hrs  
Natural Flow (Rate) \_\_\_\_\_  
Amount Used \_\_\_\_\_

Casing

From 1 To 90  
Size 6 1/4" Material P.V.C.  
Weight/Schedule S.D.R. 27

From 90 To 130  
Size 6 3/8" Material P.V.C.  
Weight/Schedule S.D.R. 21

From 105 To 245  
Size 4" Material P.V.C.  
Weight/Schedule Sch 40

Gravel Pack

From \_\_\_\_\_ To \_\_\_\_\_

From \_\_\_\_\_ To \_\_\_\_\_

From \_\_\_\_\_ To \_\_\_\_\_

Hole size

10" from 0 to 55 ft.

8 3/4" from 55 to 135 ft.

5 1/4" from 135 to 265 ft.

Grout

From 0 To 50'  
Bore Hole Size 1 1/2"  
Type Bentonite  
Method Pressure Grouting

From \_\_\_\_\_ To \_\_\_\_\_  
Bore Hole Size \_\_\_\_\_  
Type \_\_\_\_\_  
Method \_\_\_\_\_

From \_\_\_\_\_ To \_\_\_\_\_  
Bore Hole Size \_\_\_\_\_  
Type \_\_\_\_\_  
Method \_\_\_\_\_

Water Zones or Screened Intervals

From 245 To 265  
Mesh Size .020 Diam 4" P.V.C.  
From \_\_\_\_\_ To \_\_\_\_\_  
Mesh Size \_\_\_\_\_ Diam \_\_\_\_\_

approx water zone  
From 240 To 264  
Mesh Size \_\_\_\_\_ Diam \_\_\_\_\_  
From \_\_\_\_\_ To \_\_\_\_\_  
Mesh Size \_\_\_\_\_ Diam \_\_\_\_\_

From \_\_\_\_\_ To \_\_\_\_\_  
Mesh Size \_\_\_\_\_ Diam \_\_\_\_\_  
From \_\_\_\_\_ To \_\_\_\_\_  
Mesh Size \_\_\_\_\_ Diam \_\_\_\_\_

\* Use Data \*

Private Well: Domestic  Agricultural \_\_\_\_\_ Industrial \_\_\_\_\_ Monitoring \_\_\_\_\_  
Public Well: Community \_\_\_\_\_ Non Community \_\_\_\_\_

\* Abandonment Information \*

Bored or Dug Wells

Casing Removed, Y or N? \_\_\_\_\_  
If Y, Depth to which casing was removed: \_\_\_\_\_  
Depth and Type of Fill: \_\_\_\_\_  
Source of Fill \_\_\_\_\_  
Bentonite Plugs: From \_\_\_\_\_ to \_\_\_\_\_ From \_\_\_\_\_ to \_\_\_\_\_

Wells other than Bored Wells


Casing removed, Y or N? \_\_\_\_\_  
Depth to which casing was removed: \_\_\_\_\_  
Applicable, depth(s), and type of gravel/sand fill: \_\_\_\_\_  
Source of gravel or sand: \_\_\_\_\_  
Cement: From \_\_\_\_\_ to \_\_\_\_\_ From \_\_\_\_\_ to \_\_\_\_\_

Method of permanently marking location: \_\_\_\_\_

Installed watertight top  
Suggest setting pump @ approx. 220 ft. Well pumped 12 GPM @ 220' on 7/25/96  
Casing will telescope to 4" @ approx. 105'  
Suggest suspending centralizers & torque arrestors out of

James Hovner Builder  
 Quarry Rd.  
 Stafford  
 Decatur Rd → L. on Brent Point Road → R. on Quarry Rd  
 Drillers Log

Depth	Description of Formation or Sediment	Remarks
0	3	Fill
3	15	yellow Sand & Gravel
15	25	Sandy Gray clay
25	60	Gray clay
60	85	Sandstone
85	90	Gray clay
90	130	Sandstone
130	180	Gray & Brown clay
180	205	Brown clay
205	225	Gray clay
225	240	Sandy grey clay
240	264	Grey sand
264	265	Grey clay

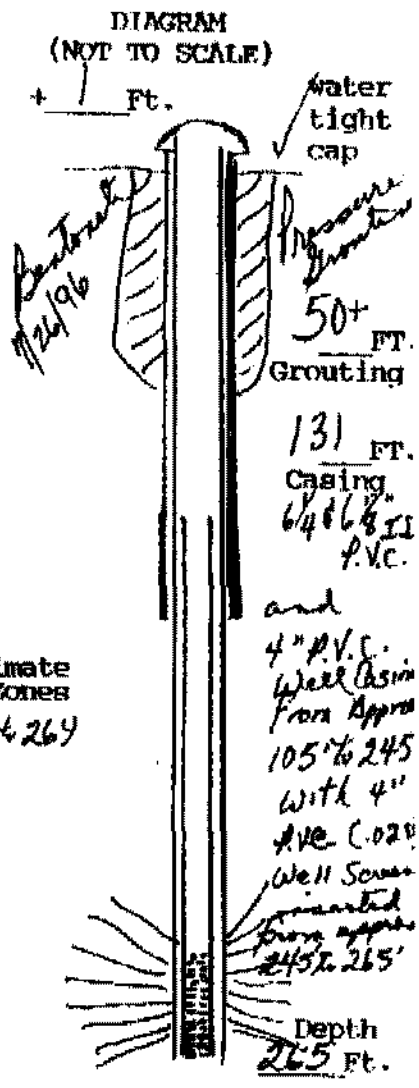

Approximate  
 Water Zones  
 240 to 264

(Use additional Sloots if necessary)

I certify that the information contained here is true and that this well was installed and constructed in accordance with the permit and further that the well complies with all applicable state and local regulations, ordinances and laws.

Name JOHN L. DANIELSON, JR., INC.  
 Address 4616 HOOD DRIVE  
FREDERICKSBURG, VIRGINIA 22408  
 Phone 578 (388) 898-6025 / 898-9355

Drillers Signature John L. Danielson, Pres.  
 Date 7/26/96 Representing JOHN L. DANIELSON, JR., INC.

Virginia Contractors License Number CLASS A 2701 014084A II/II WMC