


Forest Hill Associates
Lachia Leonard
Stafford

n1 → 639 → Midway → 611 → R. on Decatur → L. on Bent Point → R. on Quarry
 R. on Quarry Catfish Road Drillers Log - 1st Drive on left.

Depth	Description of Formation or Sediment
0	10 Red Clay
10	80 Yellow Sand
80	150 Sandy Gravel
150	210 Grey Clay
210	250 Sandy Grey Clay
250	300 Grey Clay
300	310 Sandy Grey Clay
310	344 Grey Sand - water zone
344	347 Grey Clay

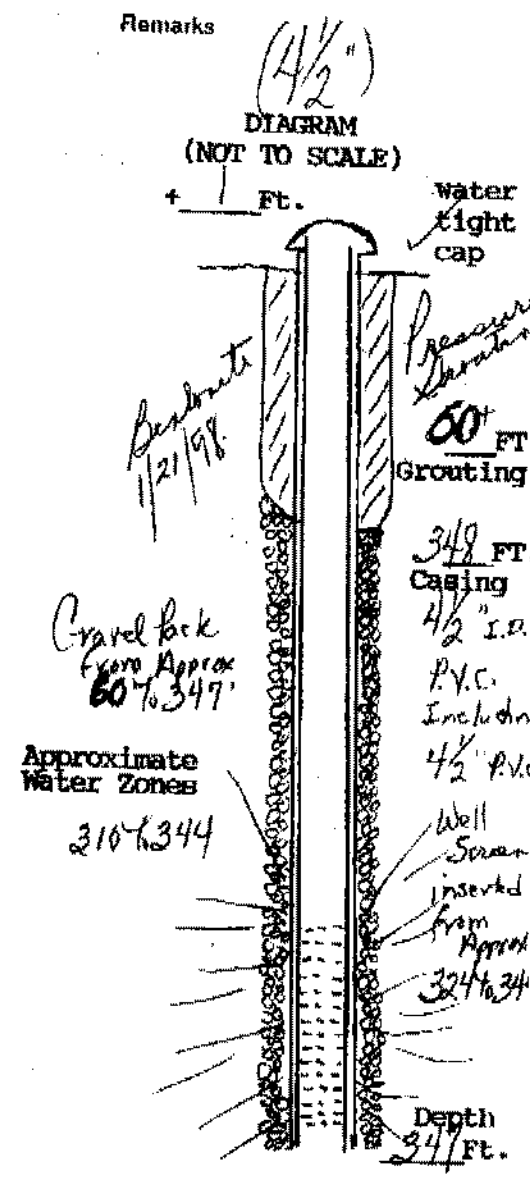

(User additional Sheets if necessary)

I certify that the information contained here is true and that this well was installed and constructed in accordance with the permit and further that the well complies with all applicable state and local regulations, ordinances and laws.

Name JOHN I. DANIELSON, JR., INC.
 Address 4616 HOOD DRIVE
FREDERICKSBURG, VIRGINIA 22408
 Phone 540 (203) 898-6025 / 898-9355

Drillers Signature [Signature]
 Date 1/21/98 Representing JOHN I. DANIELSON, JR., INC.

Virginia Contractors License Number CLASS A 2701 014084A H/H WMC