

**Commonwealth of Virginia
Uniform Water Well Completion Report**

Owner Arthur Lee Ferguson
 Address 18 Willies Lane
Stafford, Va. 22554
 Phone W 1-703-293-7705 H 720-5626 M 659-7592
 Location 18 Willies Lane / Wide water
#1 -> Rt on 611 -> L. on 635 -> Willies Lane

Tax Map ID 31-77A
 VDH Permit WS-91-235
 VWCB Permit _____
 VWCB ID _____
 County Stafford
1/9/92 Norm DeWicker
1/15/92 TT Thompson
192A

* Well Data *

General Information

Drilling Method Mud Rotary
 Depth to Bedrock _____
 Static Water Level 50
 Well Disinfected (Y or N) _____

Date Completed 7/14/92
 Yield 20 (GPM)
 Stabilized Water Level 60
 Disinfectant Used _____

Total Depth of Well 144
 Length of Test 2 HRS.
 Natural Flow (Rate) _____
 Amount Used _____

Casing

From +1 To 90
 Size 6 1/4 Material P.V.C.
 Weight/Schedule SDR 27

From 90 To 110
 Size 6 1/2 Material P.V.C.
 Weight/Schedule SDR 27

From 84 To 124
 Size 4 Material P.V.C.
 Weight/Schedule Sch. 40

Gravel Pack

From _____ To _____

From _____ To _____

From _____ To _____

Grout

From 0 To 50'
 Bore Hole Size 10
 Type Bentonite 7/14/92
 Method Pressure Grouting

From 0 To 110
 Bore Hole Size 10'
 Type _____
 Method _____

From 110 To 144
 Bore Hole Size 6"
 Type _____
 Method _____

Water Zones or Screened Intervals

From 120 To 143
 Mesh Size _____ Diam _____
 From 124' To 144'
 Mesh Size .020 Diam 4"

From _____ To _____
 Mesh Size _____ Diam _____
 From _____ To _____
 Mesh Size _____ Diam _____

From _____ To _____
 Mesh Size _____ Diam _____
 From _____ To _____
 Mesh Size _____ Diam _____

* Use Data *

Private Well: Domestic Agricultural _____ Industrial _____ Monitoring _____
 Public Well: Community _____ Non Community _____

* Abandonment Information *

Bored or Dug Wells

Casing Removed, Y or N?: _____
 If Y, Depth to which casing was removed: _____
 Depth and Type of Fill: _____
 Source of Fill _____
 Bentonite Plugs: From _____ to _____ From _____ to _____

Wells other than Bored Wells

Casing removed, Y or N? _____
 Depth to which casing was removed: _____
 Applicable, depth(s), and type of gravel/sand fill: _____
 Source of gravel or sand: _____
 Cement: From _____ to _____ From _____ to _____

Method of permanently marking location:


- Installed watertight top
 - Suggest setting pump @ approx. 80 FT.

Arthur Ferguson

* Drillers Log *

Depth	Description of Formation or Sediment	Remarks
0 20	Sandy Clay	
20 80	Grey Sandy Clay	
80 100	Grey Sand & Gravel	
100 115	Grey Clay	
115 120	Sandy Grey Clay	
120 143	Grey Sand	
143 144	Grey Clay	

DIAGRAM (NOT TO SCALE)

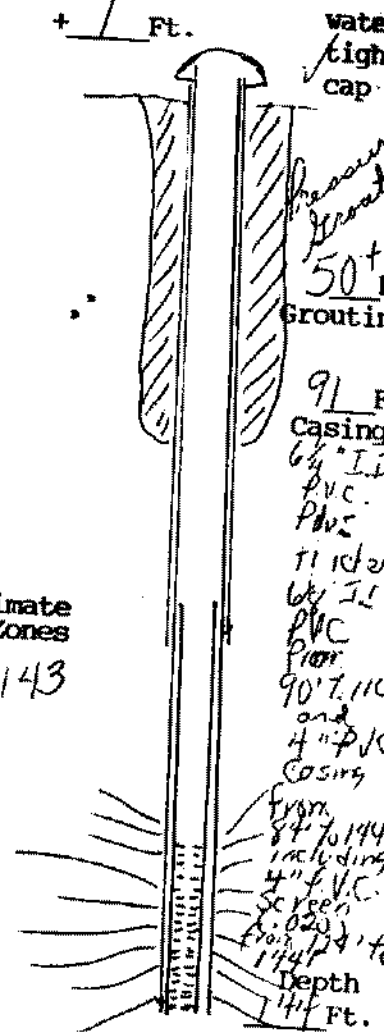

Approximate Water Zones
120 to 143

(User additional Sheets if necessary)

I certify that the information contained here is true and that this well was installed and constructed in accordance with the permit and further that the well complies with all applicable state and local regulations, ordinances and laws.

Name JOHN L. DANIELSON, JR., INC.
 Address 4616 HOOD DRIVE
FREDERICKSBURG, VIRGINIA 22408
 Phone (703) 898-6025 / 898-9355

Drillers Signature John L. Danielson
 Date 7/17/92 Representing JOHN L. DANIELSON, JR., INC.

Virginia Contractors License Number _____