

LANE P. 1
VA 20181
754-1714

Commonwealth of Virginia Uniform Water Well Completion Report

Owner Jeff Storm
Address 102 Abbey Ln, Fredericksburg VA
Phone 540-373-4745
Location Shenwood Estates Sec 3 Lot 35

Tax Map ID 33-3-35
VOH Permit SLWP 00-26
VWCB Permit _____
VWCB ID _____
County STAFFORD CO.

*** Well Data ***

CLASS III B

General Information

Drilling Method Air Rotary
Depth to Bedrock 35'
Static Water Level 25'
Well Disinfected (Y or N) N

Date Completed 5/9/00
Yield 15 (GPM)
Stabilized Water Level _____
Disinfectant Used _____

Total Depth of Well 300'
Length of Test 1 hr.
Natural Flow (Rate) N
Amount Used _____

Casing From +1 1/2' To 53 1/2'
Size 6" x 3/4" Material PVC
Weight/Schedule 3.491 lb per ft.

From _____ To _____
Size _____ Material _____
Weight/Schedule _____

From _____ To _____
Size _____ Material _____
Weight/Schedule _____

1 water tight well cap
Gravel Pack
From _____ To _____

From _____ To _____

From _____ To _____

Grout From 53 1/2' To 0
Bore Hole Size 10" x 53 1/2'
Type Bentonite (E-2 sand)
Method pressure grout from bottom to top

From _____ To _____
Bore Hole Size _____
Type _____
Method _____

From _____ To _____
Bore Hole Size _____
Type _____
Method _____

Water Zones or Screened Intervals
From 167 To 169
Mesh Size _____ Diam _____
From _____ To _____
Mesh Size _____ Diam _____

From 282 To 283
Mesh Size _____ Diam _____
From _____ To _____
Mesh Size _____ Diam _____

From _____ To _____
Mesh Size _____ Diam _____
From _____ To _____
Mesh Size _____ Diam _____

*** Use Data ***

Private Well: Domestic Agricultural _____ Industrial _____ Monitoring _____
Public Well: Community _____ Non Community _____

*** Abandonment Information ***

Bored or Dug Wells
Casing Removed, Y or N? _____
If Y, Depth to which casing was removed: _____
Depth and Type of Fill: _____
Source of Fill: _____
Bentonite Plugs: From _____ to _____ From _____ to _____


Wells other than Bored Wells
Casing removed, Y or N? _____
Depth to which casing was removed: _____
Applicable, depth(s), and type of gravel/sand fill: _____
Source of gravel or sand: _____
Cement: From _____ to _____ From _____ to _____

Method of permanently marking location: _____

Drillers' Log

NOT TO SCALE

Depth	Description of Formation or Sediment
0-35'	overburden (clay) orange
35'-47'	brown shale
49'-300'	blue granite

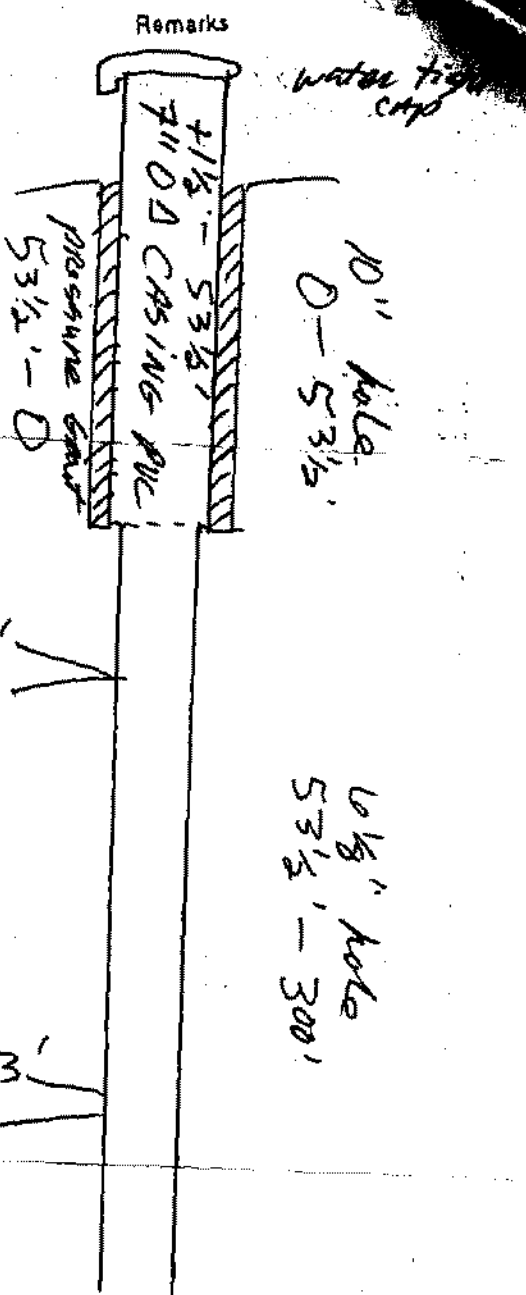

167'-169'
2 GPM

282'-283'
13 GPM

10" hole
0-5 3/4'

10 1/8" hole
5 3/4'-300'

(User additional Sheets if necessary)

I certify that the information contained here is true and that this well was installed and constructed in accordance with the permit and I understand that the well complies with all applicable state and local regulations, ordinances and laws.

Name Artesian Water Wells, Inc.
 Address 11412 Gordon Rd. Frying Pan VA 22407
 Phone (540) 785-8163
 Driller's Signature Wade N. Smyth
 Date 5/9/00 Representing AWWI
 Virginia Contractor's License Number 2705-046112