

**COMMONWEALTH OF VIRGINIA**  
**WATER WELL COMPLETION REPORT**  
 (Certification of Completion/County Permit)

BWCM No. \_\_\_\_\_  
 33A-1-4

Water Control Board  
 P. O. Box 11143  
 2111 North Hamilton St.  
 Richmond, Va. 23230

County/City Stafford County/City Stamp

• Virginia-Plane Coordinates  
 \_\_\_\_\_ N  
 \_\_\_\_\_ E  
 Latitude & Longitude  
 \_\_\_\_\_ N  
 \_\_\_\_\_ W  
 • Topo. Map No. \_\_\_\_\_  
 • Elevation \_\_\_\_\_ ft.  
 • Formation \_\_\_\_\_  
 • Lithology \_\_\_\_\_  
 • River Basin \_\_\_\_\_  
 • Province \_\_\_\_\_  
 • Type Logs \_\_\_\_\_  
 • Cuttings \_\_\_\_\_  
 • Water Analysis \_\_\_\_\_  
 • Aquifer Test \_\_\_\_\_

• Owner Chip Long Hamatores Builders  
 • Well Designation or Number 33A-4  
 Address 811 Forbes St  
Fredericksburg Va 22405  
 Phone 373-0675  
 • Drilling Contractor P. L. Curtis Well Co  
 Address 5069 Summerdale Rd  
Summersville Va 22742  
 Phone 439-8377

SWCB Permit \_\_\_\_\_  
 County Permit \_\_\_\_\_  
 Certification of inspecting official:  
 This well does \_\_\_\_\_ does not \_\_\_\_\_  
 meet code/low requirements.  
 S. \_\_\_\_\_  
 Date \_\_\_\_\_  
 For Office Use

Tax Map I.D. No. 51P-94 366  
 Subdivision Sherwood  
 Section \_\_\_\_\_  
 Block \_\_\_\_\_  
 Lot 4  
 Class Well: I \_\_\_\_\_ IIA \_\_\_\_\_  
 IIB \_\_\_\_\_ IIIA \_\_\_\_\_ IIIB   
 IIIC \_\_\_\_\_ IIID \_\_\_\_\_ IIIE \_\_\_\_\_

WELL LOCATION: \_\_\_\_\_ (feet/miles \_\_\_\_\_ direction) of \_\_\_\_\_  
 and \_\_\_\_\_ (direction) of \_\_\_\_\_  
 (If possible please include map showing location marked)  
 Date started 6/8/95 • Date completed 6/8/95 Type rig Air

1. WELL DATA: New  Reworked \_\_\_\_\_ Deepened \_\_\_\_\_  
 • Total depth 145 ft.  
 • Depth to bedrock 60 ft.  
 • Hole size (Also include reamed zones)  
 • 10 inches from 0 to 72 ft.  
 • 6 inches from 72 to 143 ft.  
 • \_\_\_\_\_ inches from \_\_\_\_\_ to \_\_\_\_\_ ft.  
 • Casing size (I.D.) and material  
 • \_\_\_\_\_ inches from \_\_\_\_\_ to \_\_\_\_\_ ft.  
 Material \_\_\_\_\_  
 Wt. per foot \_\_\_\_\_ or wall thickness \_\_\_\_\_ in.  
 • \_\_\_\_\_ inches from \_\_\_\_\_ to \_\_\_\_\_ ft.  
 Material \_\_\_\_\_  
 Wt. per foot \_\_\_\_\_ or wall thickness \_\_\_\_\_ in.  
 • Screen size and mesh for each zone (where applicable)  
 • \_\_\_\_\_ inches from \_\_\_\_\_ to \_\_\_\_\_ ft.  
 • Mesh size \_\_\_\_\_ Type \_\_\_\_\_  
 • \_\_\_\_\_ inches from \_\_\_\_\_ to \_\_\_\_\_ ft.  
 • Mesh size \_\_\_\_\_ Type \_\_\_\_\_  
 • \_\_\_\_\_ inches from \_\_\_\_\_ to \_\_\_\_\_ ft.  
 • Mesh size \_\_\_\_\_ Type \_\_\_\_\_  
 • \_\_\_\_\_ inches from \_\_\_\_\_ to \_\_\_\_\_ ft.  
 • Mesh size \_\_\_\_\_ Type \_\_\_\_\_  
 • Gravel pack  
 • From \_\_\_\_\_ to \_\_\_\_\_ ft.  
 • From \_\_\_\_\_ to \_\_\_\_\_ ft.  
 • Grout  
 • From 0 to 60 ft. Type Pressure  
 • From \_\_\_\_\_ to \_\_\_\_\_ ft. Type \_\_\_\_\_

2. WATER DATA • Water temperature \_\_\_\_\_ OF  
 • Static water level (unpumped level-measured) 28 ft.  
 • Stabilized measured pumping water level 144 ft.  
 • Stabilized yield 29 gpm after 3 hours  
 Natural Flow: Yes \_\_\_\_\_ No \_\_\_\_\_ flow rate \_\_\_\_\_ gpm  
 Comment on quality \_\_\_\_\_  
 3. WATER ZONES: From 126 To 128  
 From \_\_\_\_\_ To \_\_\_\_\_ From \_\_\_\_\_ To \_\_\_\_\_  
 From \_\_\_\_\_ To \_\_\_\_\_ From \_\_\_\_\_ To \_\_\_\_\_  
 4. USE DATA:  
 Type of use: Drinking  Livestock Watering \_\_\_\_\_  
 Irrigation \_\_\_\_\_ Food processing \_\_\_\_\_ Household   
 Manufacturing \_\_\_\_\_ Fire safety \_\_\_\_\_ Cleaning \_\_\_\_\_  
 Recreation \_\_\_\_\_ Aesthetic \_\_\_\_\_ Cooling or heating \_\_\_\_\_  
 Injection \_\_\_\_\_ Other \_\_\_\_\_  
 • Type of facility: Domestic  Public water supply \_\_\_\_\_  
 Public institution \_\_\_\_\_ Farm \_\_\_\_\_ Industry \_\_\_\_\_  
 Commercial \_\_\_\_\_ Other \_\_\_\_\_  
 5. PUMP DATA: Type \_\_\_\_\_ Rated H.P. \_\_\_\_\_  
 • Intake depth \_\_\_\_\_ Capacity \_\_\_\_\_ at \_\_\_\_\_ head  
 6. WELLHEAD: Type well seal \_\_\_\_\_  
 Pressure tank \_\_\_\_\_ gal. Loc. \_\_\_\_\_  
 Sample tap \_\_\_\_\_ Measurement port \_\_\_\_\_  
 Well vent \_\_\_\_\_ Pressure relief valve \_\_\_\_\_  
 Gate valve \_\_\_\_\_ Check valve (when required) \_\_\_\_\_  
 Electrical disconnect switch on power supply \_\_\_\_\_  
 7. DISINFECTION: Well disinfected \_\_\_\_\_ yes \_\_\_\_\_ no \_\_\_\_\_  
 Date \_\_\_\_\_ Disinfectant used \_\_\_\_\_  
 Amount \_\_\_\_\_ Hours used \_\_\_\_\_  
 8. ABANDONMENT (where applicable) • yes \_\_\_\_\_ no \_\_\_\_\_  
 Casing pulled yes \_\_\_\_\_ no \_\_\_\_\_ not applicable \_\_\_\_\_  
 Plugging grout From \_\_\_\_\_ to \_\_\_\_\_ material \_\_\_\_\_

Owner James Town Builders Inc

BWCM

570-0051

9. State law requires submitting to the Virginia State Water Control Board information about groundwater and wells for every well made in the State intended for water, or any other non-exempt well. This information must be submitted whether the well is completed, on standby, or abandoned. Information required includes: an accurately and completely prepared water well completion report, full data from any aquifer pumping tests, drill cuttings taken at ten foot intervals (unless exemption is secured), the results of any chemical analyses, and copies of any geophysical logs. Quarterly pumpage and use reports are required from owners of public supply and industrial wells. County or State permits to drill may be required in some parts of the state. Some counties require submission of a water well completion report. The Virginia State Health Department requires a water well completion report for public supply wells.

10. DRILLERS LOG (use additional Sheets if necessary)


DEPTH (feet)		TYPE OF ROCK OR SOIL (color, material, fossils, hardness, etc.)	REMARKS (water, casing, cavities, broken, core, shot, etc.)
From	To		
0	60	Brown soil	
60	145	Sand stone	



11. Drilling Time (Min.)

12. DIAGRAM OF WELL CONSTRUCTION (with dimensions)

Well 145 ft  
72 ft casing  
60 ft grout  
air tight cap

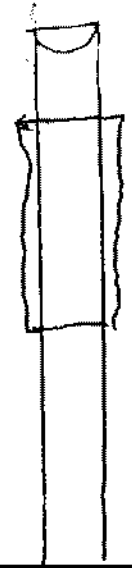

13. Well lot dedicated? \_\_\_\_\_ Size \_\_\_\_\_ ft. X \_\_\_\_\_ ft. Well house? \_\_\_\_\_  
Distance to nearest pollutant source \_\_\_\_\_ ft. Type \_\_\_\_\_  
Distance to nearest property line \_\_\_\_\_ ft. Building \_\_\_\_\_ ft.

14. WATER SERVICE PIPE: Checked under \_\_\_\_\_ p.s.i. for \_\_\_\_\_ minutes. Pipe size \_\_\_\_\_ inches, Material \_\_\_\_\_  
Installer \_\_\_\_\_  
Date \_\_\_\_\_

State Water Control Board Regional Offices

Valley Reg. Off.  
116 North Main Street  
P. O. Box 268  
Bridgewater, Va. 22812  
703-628-2595

Piedmont Reg. Off.  
4010 West Broad Street  
P. O. Box 6616  
Richmond, Va. 23230  
804-257-1006

Southwest Reg. Off.  
406 East Main Street  
P. O. Box 476  
Abingdon, Va. 24210  
703-628-5183

Tidewater Reg. Off.  
287 Pembroke Office Park  
Suite 310 Pembroke No. 2  
Va. Beach, Va. 23462  
804-499-8742

West Central Reg. Off.  
Executive Park  
5312 Peters Creek Road  
Roanoke, Va. 24019  
708-982-7432

Northern Virginia Reg. Off.  
5515 Cherokee Avenue  
Suite 404  
Alexandria, Va. 22312  
703-750-9111

15. I certify that the information contained herein is true and correct and that this well and/or system has been installed and constructed in accordance with the requirements for well construction as specified in compliance with appropriate county or independent city ordinances and the laws and rules of the Commonwealth of Virginia.

Signature Raymond L Curtis (Seal Date 6/8/95)  
(Well driller or authorized person)  
License No. 0.35303 A