

Commonwealth of Virginia

Uniform Water Well Completion Report

Ernest L. Austin Homes  
Apartment North East  
P.O. 1659  
Spotsylvania, Va 22550  
785-8750  
Owner Martin Rust / For Sale  
Address \_\_\_\_\_

Tax Map ID 33A-1-5  
35A-5  
VDH Permit SWP-95-136  
VWCB Permit \_\_\_\_\_  
VWCB ID \_\_\_\_\_  
County STAFFORD  
5/3/95 Ab Snyder  
D.J.

Phone \_\_\_\_\_  
Location Sherwood Estates #5  
183A  
Well Classification IIIA \_\_\_\_\_ IIIB  IIIC \_\_\_\_\_ IV \_\_\_\_\_  
Approx 1/2 M. South of Sta #174784 \* Well Data \*  
1/2 M. West of #734

General Information

Drilling Method Bit Rotary  
Depth to Bedrock 65'  
Static Water Level approx 40  
Well Disinfected (Y or N) \_\_\_\_\_

Date Completed \_\_\_\_\_  
Yield 60 (GPM)  
Stabilized Water Level approx 40'  
Disinfectant Used \_\_\_\_\_

Total Depth of Well 240  
Length of Test approx 1 Hr.  
Natural Flow (Rate) \_\_\_\_\_  
Amount Used \_\_\_\_\_

Casing

From +1 To 78  
Size 1 1/4 Material P.V.C.  
Weight/Schedule SDR 27

From \_\_\_\_\_ To \_\_\_\_\_  
Size \_\_\_\_\_ Material \_\_\_\_\_  
Weight/Schedule \_\_\_\_\_

From \_\_\_\_\_ To \_\_\_\_\_  
Size \_\_\_\_\_ Material \_\_\_\_\_  
Weight/Schedule \_\_\_\_\_

Gravel Pack

From \_\_\_\_\_ To \_\_\_\_\_

From \_\_\_\_\_ To \_\_\_\_\_

From \_\_\_\_\_ To \_\_\_\_\_

Hole size 10" from 0 to 50ft.

7 7/8" from 50 to 78 ft.

6 1/2" from 78 to 240 ft.

Grout

From 0 To 50' 8/14/95  
Bore Hole Size 10"  
Type Gypsum  
Method Pressure Grouting

From \_\_\_\_\_ To \_\_\_\_\_  
Bore Hole Size \_\_\_\_\_  
Type \_\_\_\_\_  
Method \_\_\_\_\_

From \_\_\_\_\_ To \_\_\_\_\_  
Bore Hole Size \_\_\_\_\_  
Type \_\_\_\_\_  
Method \_\_\_\_\_

Water Zones or Screened Intervals

From 100 To 101

From \_\_\_\_\_ To \_\_\_\_\_

From \_\_\_\_\_ To \_\_\_\_\_

Mesh Size \_\_\_\_\_ Diam \_\_\_\_\_

Mesh Size \_\_\_\_\_ Diam \_\_\_\_\_

Mesh Size \_\_\_\_\_ Diam \_\_\_\_\_

From 220 To 221

From \_\_\_\_\_ To \_\_\_\_\_

From \_\_\_\_\_ To \_\_\_\_\_

Mesh Size \_\_\_\_\_ Diam \_\_\_\_\_

Mesh Size \_\_\_\_\_ Diam \_\_\_\_\_

Mesh Size \_\_\_\_\_ Diam \_\_\_\_\_

\* Use Data \*

Private Well: Domestic  Agricultural \_\_\_\_\_ Industrial \_\_\_\_\_ Monitoring \_\_\_\_\_  
Public Well: Community \_\_\_\_\_ Non Community \_\_\_\_\_

\* Abandonment Information \*

Bored or Dug Wells

Casing Removed, Y or N? \_\_\_\_\_  
If Y, Depth to which casing was removed: \_\_\_\_\_  
Depth and Type of Fill: \_\_\_\_\_  
Source of Fill \_\_\_\_\_  
Bentonite Plugs: From \_\_\_\_\_ to \_\_\_\_\_ From \_\_\_\_\_ to \_\_\_\_\_

Wells other than Bored Wells

Casing removed, Y or N? \_\_\_\_\_  
Depth to which casing was removed: \_\_\_\_\_  
Applicable, depth(s), and type of gravel/sand fill: \_\_\_\_\_  
Source of gravel or sand: \_\_\_\_\_  
Cement: From \_\_\_\_\_ to \_\_\_\_\_ From \_\_\_\_\_ to \_\_\_\_\_


Method of permanently marking location: \_\_\_\_\_  
 Installed watertight top  
Suggest setting pump @ approx. 100 ft.

Martin & Dorte Rust  
 Emerald Homes  
 Sherwood Est #5  
 Stafford  
 17 → 734

• Drillers Log •

Depth Description of Formation or Sediment Remarks

0	10	Red Clay
10	65	Brown Clay
65	78	Soft Brown Rock
78	240	Light Gray Rock

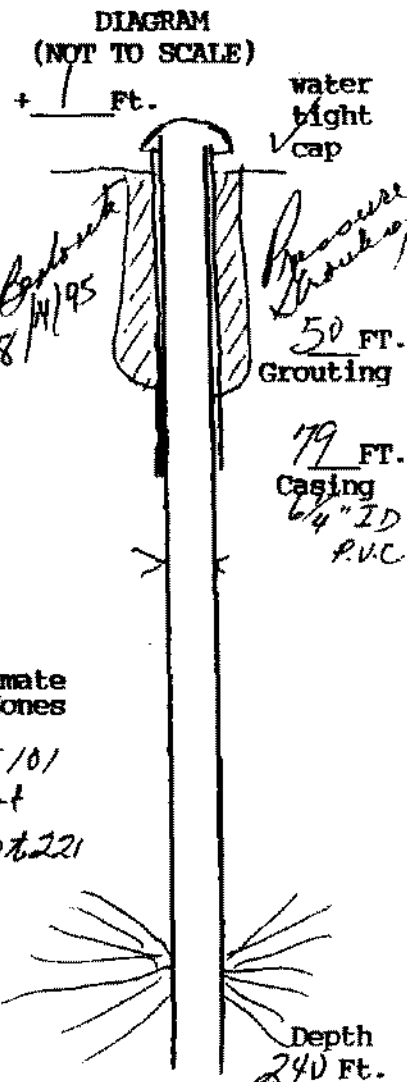

(User additional Sheets if necessary)

I certify that the information contained here is true and that this well was installed and constructed in accordance with the permit and further that the well complies with all applicable state and local regulations, ordinances and laws.

Name JOHN L. DANIELSON, JR., INC.  
 Address 4616 HOOD DRIVE  
FREDERICKSBURG, VIRGINIA 22408  
 Phone (703) 898-6025 / 898-9355

Drillers Signature John L. Danielson, Pres.  
 Date 8/14/95 Representing JOHN L. DANIELSON, JR., INC.

Virginia Contractors License Number CLASS A 2701 014084A H/H WWC

