

William & Sandra Lambert
3010 Jean Lane
Woodbridge, Va. 22192
703-491-5403 F 491-8470

Commonwealth of Virginia
Uniform Water Well Completion Report

Owner William Lambert / For Sale
Address 3010 Jean Lane
Woodbridge, Va. 22192
Phone 703-491-5403
Location Sherwood Estates Sect 2 - Lot 22
17 → 134 → Kestley Place
Well Classification IIIA III B III C IV
* Well Data *

Tax Map ID 33A-2-22
VDH Permit SWP-97-243
VWCB Permit _____
VWCB ID _____
County Stafford
4/27/97 Ashton Wright
DJC

General Information
Drilling Method Air Rotary
Depth to Bedrock 65
Static Water Level 30
Well Disinfected (Y or N) _____

Date Completed 10/2/97
Yield 50 (GPM)
Stabilized Water Level 80
Disinfectant Used _____

Total Depth of Well 200'
Length of Test Approx 1 Hr.
Natural Flow (Rate) _____
Amount Used _____

Casing 4 1/2 To 103
From _____ To _____
Size 6 1/2 Material PVC
Weight/Schedule S.D.R. 27

From _____ To _____
Size _____ Material _____
Weight/Schedule _____

From _____ To _____
Size _____ Material _____
Weight/Schedule _____

Gravel Pack
From _____ To _____
Hole size 10" from 0 to 50ft.
Grout From 0 To 50'
Bore Hole Size 10" 10/3/97
Type Bentonite
Method Pressure Grouting

From _____ To _____
Hole size 7 1/8" from 50 to 103ft.
Grout From _____ To _____
Bore Hole Size _____
Type _____
Method _____

From _____ To _____
Hole size 6 1/8" from 103 to 200ft.
Grout From _____ To _____
Bore Hole Size _____
Type _____
Method _____

Water Zones or Screened Intervals
From 120 To 121
Mesh Size _____ Diam _____
From 180 To 181
Mesh Size _____ Diam _____

From _____ To _____
Mesh Size _____ Diam _____
From _____ To _____
Mesh Size _____ Diam _____

From _____ To _____
Mesh Size _____ Diam _____
From _____ To _____
Mesh Size _____ Diam _____

* Use Data *

Private Well: Domestic Agricultural _____ Industrial _____ Monitoring _____
Public Well: Community _____ Non Community _____

* Abandonment Information *

Bored or Dug Wells
Casing Removed, Y or N? _____
If Y, Depth to which casing was removed: _____
Depth and Type of Fill: _____
Source of Fill _____
Bentonite Plugs: From _____ to _____ From _____ to _____

Wells other than Bored Wells
Casing removed, Y or N? _____
Depth to which casing was removed: _____
Applicable, depth(s), and type of gravel/sand fill: _____
Source of gravel or sand: _____
Cement: From _____ to _____ From _____ to _____

Method of permanently marking location: _____
 Installed watertight top
Suggest setting pump @ approx. 100 ft.

W.S. Lambert


Sheswood Lot # 22

Stafford

19 → 734 → Nottingham → Kirkley Place

Drillers Log

Depth	Description of Formation or Sediment	Remarks
0	10	Red Clay
10	65	Brown Clay
65	103	Brown Shale
103	200	Gray Granite

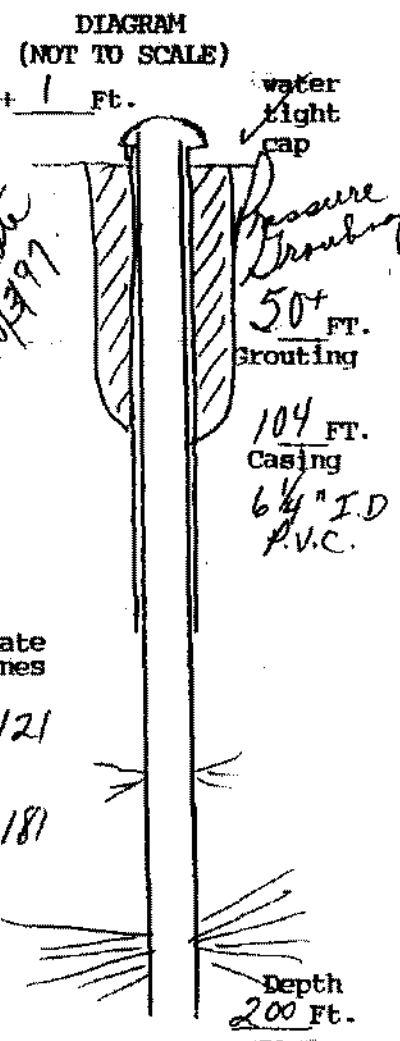

Approximate Water Zones

120 to 121 and 180 to 181

(User additional Sheets if necessary)

I certify that the information contained here is true and that this well was installed and constructed in accordance with the permit and further that the well complies with all applicable state and local regulations, ordinances and laws.

Name JOHN L. DANIELSON, JR., INC.
 Address 4616 HOOD DRIVE
FREDERICKSBURG, VIRGINIA 22408
 Phone 540 (703) 898-6025 / 898-9355

Drillers Signature John L. Danielson, Pres
 Date 10/3/97 Representing JOHN L. DANIELSON, JR., INC.

Virginia Contractors License Number CLASS A 2701 014084A II/II WVC