

**COMMONWEALTH OF VIRGINIA
WATER WELL COMPLETION REPORT**

• BWCM No. _____

State Water Control Board
P. O. Box 11143
2111 North Hamilton St.
Richmond, Va. 23230

(Certification of Completion/County Permit)

Johnson Construction
2432 Mountainview Rd.
Stafford, Va. 22554
752-1010

SWCB Permit _____
County Permit _____
Certification of inspecting official _____
This well does _____ does not _____
meet code/low requirements _____
S _____
Date _____
For Office Use

County/City Stafford

County/City Stamp

• Virginia Plane Coordinates
N _____
E _____
Latitude & Longitude
N _____
W _____
• Topo. Map No. 183A
• Elevation _____ ft.
• Formation _____
• Lithology _____
• River Basin _____
• Province _____
• Type Logs D. L.
• Cuttings N. 6.
• Water Analysis _____
• Aquifer Test _____

• Owner Bretchen & Michael Bergman
• Well Designation or Number _____
Address _____
Phone _____
• Drilling Contractor John L. Danielson, Jr., Inc.
Address 4616 Hood Drive
Fredericksburg, Virginia 22401
Phone (703) 898-6025

SD-86-152 3-27-88
Amoroso
Tax Map I.D. No. 35-100
Subdivision _____
Section _____
Block _____
Lot _____
Class Well I _____ IIA _____
IIB IIIA _____ IIIB _____
IIIC _____ IIID _____ IIIE _____

WELL LOCATION: 1 1/2 (feet/miles) W. (direction) of Intersection of 616 & 754
and 10 (feet/miles) N. (direction) of # 754
(If possible please include map showing location marked)

Date started 4/20/88 • Date completed 4/21/88 Type rig Air Rotary
Approximate Drawdown 70 feet.

WELL DATA New Reworked _____ Deepened _____
• Total depth _____ ft. 140
• Depth to bedrock _____ ft. 52
• Hole size (Also include reamed zones)
• 10 inches from _____ to 52 ft. Increased Bored
• 6 1/8 inches from 52 to 140 ft. Attempt or a rock
• Casing size (I.D.) and material
• 6 1/8 inches from +1 to 52 ft. 4/14/88
Material steel
Wt. per foot 13 lb or wall thickness .188 in.
• _____ inches from _____ to _____ ft.
Material _____
Wt. per foot _____ or wall thickness _____ in.
• _____ inches from _____ to _____ ft.
Material _____
Wt. per foot _____ or wall thickness _____ in.
• Screen size and mesh for each zone (where applicable)
• _____ inches from _____ to _____ ft.
• Mesh size _____ Type _____
• _____ inches from _____ to _____ ft.
• Mesh size _____ Type _____
• _____ inches from _____ to _____ ft.
• Mesh size _____ Type _____
• _____ inches from _____ to _____ ft.
• Mesh size _____ Type _____
• Travel pack
• From _____ to _____ ft.
• From _____ to _____ ft.
• Grout
• From 0 to 50+ ft. Type Pressure Grout
• From _____ to _____ ft. Type _____
• From _____ to _____ ft. Type _____

2. WATER DATA • Water temperature _____
• Static water level (unpumped level-measured) 40
• Stabilized measured pumping water level 110
• Stabilized yield 7 gpm after _____
Natural Flow: Yes _____ No _____ flow rate _____
Comment on quality _____

3. WATER ZONES: From 122 To 123
From _____ To _____ From _____ To _____
From _____ To _____ From _____ To _____

4. USE DATA:
Type of use Drinking Livestock Watering _____
Irrigation _____ Food processing _____ Household
Manufacturing _____ Fire safety _____ Cleaning _____
Recreation _____ Aesthetic _____ Cooling or heating _____
Injection _____ Other _____
• Type of facility Domestic Public water supply _____
Public institution _____ Farm _____ Industry _____
Commercial _____ Other _____

5. PUMP DATA: Type _____ • Rated H.P. _____
• Intake depth _____ • Capacity _____ at _____ head _____

6. WELLHEAD: Type well seal _____
Pressure tank _____ gal. Loc. _____
Sample tap _____ Measurement port _____
Well vent _____ Pressure relief valve _____
Gate valve _____ Check valve (when required) _____
Electrical disconnect switch on power supply _____

7. DISINFECTION: Well disinfected _____ yes _____ no _____
Date _____ Disinfectant used _____
Amount _____ Hours used _____

8. ABANDONMENT (where applicable) • yes _____ no _____
Casing pulled yes _____ no _____ not applicable _____
Plugging grout From _____ to _____ material _____
Pump installed through Michael Bergman

Installed Watertight top
Suggest setting pump @ 120' OVER

150 C OLDE GREENWICH DRIVE
 Gilbert W

Tolson Construction
 Owner: Bretaper & Michael Berryman
Stafford #754

9. State law requires submitting to the Virginia State Water Control Board information about groundwater and wells for every well intended for water, or any other non exempt well. This information must be submitted whether the well is completed, on standby, or abandoned. Information required includes: an accurately and completely prepared water well completion report, full data from any aquifer pumping tests, cuttings taken at ten foot intervals (unless exemption is secured), the results of any chemical analyses, and copies of any geophysical logs. Quarterly pumpage and use reports are required from owners of public supply and industrial wells. County or State permits to drill may be required in some parts of the state. Some counties require submission of a water well completion report. The Virginia State Health Department requires a water well completion report for public supply wells.

10. DRILLERS LOG (use additional Sheets if necessary)


DEPTH (feet)		TYPE OF ROCK OR SOIL (color, material, fossils, hardness, etc.)	REMARKS (water, caving, cavities, broken, core, shot, etc.)
From	To		
0	10	Brown clay	
10	30	Micaceous formation (red)	
30	40	Micaceous formation (brown)	
40	52	soft brown rock	
52	140	hard blue rock	

Approximate
 Water Zones
 122' - 123'

11.

Drilling Time (Min.)

12. DIAGRAM OF WELL CONSTRUCTION (with dimensions)

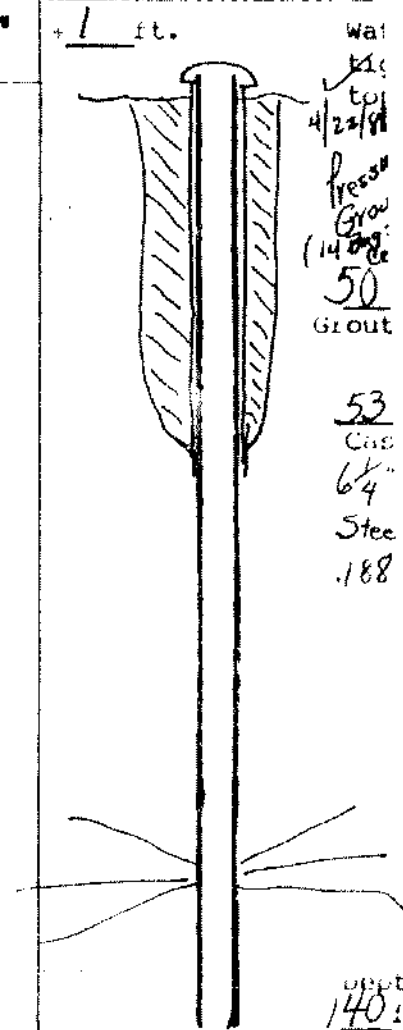

13. Well lot dedicated? _____ Size _____ ft X _____ ft. Well house? _____
 Distance to nearest pollutant source _____ ft. Type _____
 Distance to nearest property line _____ ft. Building _____ ft.

14. WATER SERVICE PIPE: Checked under _____ p.s.f. for _____
 minutes. Pipe size _____ inches, Material _____
 Installer _____
 Date _____

State Water Control Board Regional Offices

Valley Reg. Off.
 116 North Main Street
 P. O. Box 268
 Bridgewater, Va. 22812
 703-828-2595

Piedmont Reg. Off.
 4010 West Broad Street
 P. O. Box 6616
 Richmond, Va. 23230
 804-257-1006

Southwest Reg. Off.
 408 East Main Street
 P. O. Box 426
 Abingdon, Va. 24210
 703-828-5181

Tidewater Reg. Off.
 287 Pembroke Office Park
 Suite 310 Pembroke No. 2
 Va. Beach, Va. 23462
 804-999-8742

West Central Reg. Off.
 Executive Park
 5312 Peters Creek Road
 Roanoke, Va. 24019
 703-982-7452

Northern Virginia Reg. Off.
 5515 Cherokee Avenue
 Suite 404
 Alexandria, Va. 22312
 703-750-9111

15. I certify that the information contained herein is true and correct and that this well and/or system has been installed and constructed in accordance with the requirements for well construction as specified in compliance with appropriate county or independent city ordinances and the laws and rules of the Commonwealth of Virginia.

Signature: Arnold Danielson Seal, Date: 4/25/88
 (Well driller or authorized person) License No. _____