

**COMMONWEALTH OF VIRGINIA
WATER WELL COMPLETION REPORT**

• BWCM No. _____


(Certification of Completion/County Permit)

35-70-2

Control Board
Box 11143
2111 North Hamilton St.
Richmond, Va. 23230

County/City Stafford VA

County/City Stamp _____

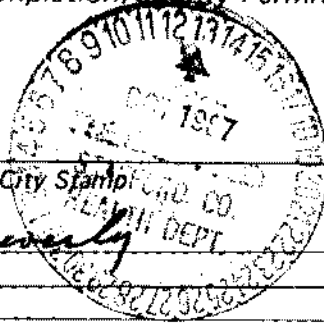

SWCB Permit _____
County Permit _____

Certification of inspecting official:
This well does _____ does not _____
meet code/low requirements.
S. _____
Date _____

For Office Use

• Virginia Plane Coordinates
N _____
E _____
Latitude & Longitude
N _____
W _____

• Topo. Map No. _____
• Elevation _____ ft.
• Formation _____
• Lithology _____
• River Basin _____
• Province _____
• Type Logs Driller
• Cuttings no
• Water Analysis _____
• Aquifer Test _____

• Owner Rodger Beverly
• Well Designation or Number _____
Address 906g. VA.
Phone _____

• Drilling Contractor Kay George Drilling Service
Address Rt 1 Box 117
Colonial Beach VA
Phone _____

Tax Map I.D. No. _____
Subdivision _____
Section _____
Block _____
Lot _____
Class Well I _____ IIA _____
IIB _____ IIIA _____ IIIB
IIIC _____ IIID _____ IIIE _____

WELL LOCATION: 1.0 (feet/miles west direction) of Rt 17
and 1/4 (feet/miles W) (direction) of Rt 724
(If possible please include map showing location marked)

Date started 7-31-87 • Date completed 7-31-87 Type rig Rotary

1. WELL DATA: New Reworked _____ Deepened _____

• Total depth 57 ft.
• Depth to bedrock _____ ft.

• Hole size (Also include reamed zones)
• 44 inches from 0 to 20 ft.
• 40 inches from 20 to 57 ft.
• _____ inches from _____ to _____ ft.

• Casing size (I.D.) and material
• 30 inches from 41 to 57 ft.
Material Concrete
Wt. per foot _____ or wall thickness 2 in.
• X inches from _____ to _____ ft.
Material _____
Wt. per foot _____ or wall thickness _____ in.
• X inches from _____ to _____ ft.
Material _____
Wt. per foot _____ or wall thickness _____ in.

• Screen size and mesh for each zone (where applicable)
• X inches from _____ to _____ ft.
• Mesh size _____ Type _____
• _____ inches from _____ to _____ ft.
• Mesh size _____ Type _____
• X inches from _____ to _____ ft.
• Mesh size _____ Type _____
• X inches from _____ to _____ ft.
• Mesh size _____ Type _____

• Gravel pack
• From 20 to 57 ft.
• From _____ to _____ ft.

• Grout
• From 0 to 20 ft., Type Cement
• From _____ to _____ ft., Type _____

2. WATER DATA • Water temperature _____ OF

• Static water level (unpumped level measured) 37 ft.
• Stabilized measured pumping water level 45 ft.
• Stabilized yield 42 gpm after 24 hours
Natural Flow: Yes _____ No _____, flow rate: _____ gpm
Comment on quality good

3. WATER ZONES: From 37 To 57
From _____ To _____ From _____ To _____
From _____ To _____ From _____ To _____

4. USE DATA:
Type of use: Drinking Livestock Watering _____
Irrigation _____ Food processing _____ Household
Manufacturing _____ Fire safety _____ Cleaning _____
Recreation _____ Aesthetic _____ Cooling or heating _____
Injection _____ Other _____

• Type of facility Domestic Public water supply _____
Public institution _____ Farm _____ Industry _____
Commercial _____ Other _____

5. PUMP DATA: Type _____ • Rated H.P. _____
• Intake depth _____ • Capacity _____ at _____ head

6. WELLHEAD: Type well seal concrete caps
Pressure tap _____ gal., Loc. _____
Sample tap _____ Measurement port _____
Well vent _____ Pressure relief valve _____
Gate valve _____ Check valve (when required) _____
Electrical disconnect switch on power supply _____

7. DISINFECTION: Well disinfected _____ yes _____ no _____
Date _____, Disinfectant used _____
Amount _____, Hours used _____

8. ABANDONMENT (where applicable) • yes _____ no _____
Casing pulled yes _____ no _____ not applicable _____
Plugging grout From _____ to _____ material _____

OVER

Owner _____

BWCM No. _____

9. State law requires submitting to the Virginia State Water Control Board information about groundwater and wells for every well made in the State intended for water, or any other non-exempt well. This information must be submitted whether the well is completed, on standby, or abandoned. Information required includes: an accurately and completely prepared water well completion report, full data from any aquifer pumping tests, drill cuttings taken at ten foot intervals (unless exemption is secured), the results of any chemical analyses, and copies of any geophysical logs. Quarterly pumpage and use reports are required from owners of public supply and industrial wells. County or State permits to drill may be required in some parts of the state. Some counties require submission of a water well completion report. The Virginia State Health Department requires a water well completion report for public supply wells.

10. DRILLERS LOG (use additional Sheets if necessary)

11.

12. DIAGRAM OF WELL CONSTRUCTION (with dimensions)

DEPTH (feet)		TYPE OF ROCK OR SOIL (color, material, fossils, hardness, etc.)	REMARKS (water, caving, cavities, broken, core, shot, (etc.))	Drilling Time (Min.)
From	To			
0	2	Top Soil		
2	20	Brown & white sandy sandy clay		
20	57	Brown & wh. to sand mixed with fine gravel & some stones		

13. Well lot dedicated? _____; Size _____ ft. X _____ ft.; Well house? _____
Distance to nearest pollutant source _____ ft., Type _____
Distance to nearest property line _____ ft., Building _____ ft.

14. WATER SERVICE PIPE: Checked under _____ p.s.i. for _____ minutes. Pipe size _____ inches, Material _____
Installer _____
Date _____

15. I certify that the information contained herein is true and correct and that this well and/or system has been installed and constructed in accordance with the requirements for well construction as specified in compliance with appropriate county or independent city ordinances and the laws and rules of the Commonwealth of Virginia.

State Water Control Board Regional Offices

Valley Reg. Off.
116 North Main Street
P. O. Box 268
Bridgewater, Va. 22812
703-828-2595

Piedmont Reg. Off.
4010 West Broad Street
P. O. Box 6616
Richmond, Va. 23230
804-257-1006

Southwest Reg. Off.
408 East Main Street
P. O. Box 476
Abingdon, Va. 24210
703-628-5183

Tidewater Reg. Off.
287 Pembroke Office Park
Suite 310 Pembroke No. 2
Va. Beach, Va. 23462
804-499-8742

West Central Reg. Off.
Executive Park
5312 Peters Creek Road
Roanoke, Va. 24019
708-982-7432

Northern Virginia Reg. Off.
5515 Cherokee Avenue
Suite 404
Alexandria, Va. 22312
703-750-9111

Signature C. E. Kuhn (Seal), Date 9-2-87
(Well driller or authorized person)

License No. 073065 Va.
MD-209