

*Mellon*  
*Shackelford Home Builders*  
 P.O. Box 840  
 Harrisonville, VA 22463 Commonwealth of Virginia  
 659-1113 Fax 720-8196 Uniform Water Well Completion Report

Owner *Sunshine Home Builders*  
 Address *P.O. Box 840*  
*Harrisonville, VA 22463*  
 Phone *659-1113*  
 Location *Shackelford Well Pat. #2*  
*109 Shackelford Well Road*  
 Well Classification IIIA  IIIB  IIIC  IV   
 \* Well Data \*

Tax Map ID *35-58I-2*  
 VDH Permit *SWP-99-572*  
 VWCB Permit \_\_\_\_\_  
 VWCB ID \_\_\_\_\_  
 County *Stafford*  
*8/18/99* *John Morley*  
*DJC*

General Information  
 Drilling Method *Open Rotary*  
 Depth to Bedrock *25*  
 Static Water Level *30'*  
 Well Disinfected (Y or N) \_\_\_\_\_

Date Completed *11/29/99*  
 Yield *25* (GPM)  
 Stabilized Water Level *80'*  
 Disinfectant Used \_\_\_\_\_

Total Depth of Well *200*  
 Length of Test *approx 1 Hr.*  
 Natural Flow (Rate) \_\_\_\_\_  
 Amount Used \_\_\_\_\_

Casing  
 From *1* To *60*  
 Size *6 1/4* Material *P.V.C.*  
 Weight/Schedule *SDR 27*

From \_\_\_\_\_ To \_\_\_\_\_  
 Size \_\_\_\_\_ Material \_\_\_\_\_  
 Weight/Schedule \_\_\_\_\_

From \_\_\_\_\_ To \_\_\_\_\_  
 Size \_\_\_\_\_ Material \_\_\_\_\_  
 Weight/Schedule \_\_\_\_\_

Gravel Pack  
 From \_\_\_\_\_ To \_\_\_\_\_  
 Hole size *10"* From *0* to *50* ft.  
 Grout From *0* To *50* *11/30/99*  
 Bore Hole Size *10"*  
 Type *Bestonite*  
 Method *Pressure Grouting*

From \_\_\_\_\_ To \_\_\_\_\_  
 Hole size *8 1/2"* From *50* to *60* ft.  
 Bore Hole Size \_\_\_\_\_  
 Type \_\_\_\_\_  
 Method \_\_\_\_\_

From \_\_\_\_\_ To \_\_\_\_\_  
 Hole size *6 1/4"* From *60* to *200* ft.  
 Bore Hole Size \_\_\_\_\_  
 Type \_\_\_\_\_  
 Method \_\_\_\_\_

Water Zones or Screened Intervals  
 From *120* To *121*  
 Mesh Size \_\_\_\_\_ Diam \_\_\_\_\_  
 From *180* To *181*  
 Mesh Size \_\_\_\_\_ Diam \_\_\_\_\_

From \_\_\_\_\_ To \_\_\_\_\_  
 Mesh Size \_\_\_\_\_ Diam \_\_\_\_\_  
 From \_\_\_\_\_ To \_\_\_\_\_  
 Mesh Size \_\_\_\_\_ Diam \_\_\_\_\_

From \_\_\_\_\_ To \_\_\_\_\_  
 Mesh Size \_\_\_\_\_ Diam \_\_\_\_\_  
 From \_\_\_\_\_ To \_\_\_\_\_  
 Mesh Size \_\_\_\_\_ Diam \_\_\_\_\_

\* Use Data \*

Private Well: Domestic  Agricultural \_\_\_\_\_ Industrial \_\_\_\_\_ Monitoring \_\_\_\_\_  
 Public Well: Community \_\_\_\_\_ Non Community \_\_\_\_\_

\* Abandonment Information \*

Bored or Drug Wells  
 Casing Removed, Y or N? \_\_\_\_\_  
 If Y, Depth to which casing was removed: \_\_\_\_\_  
 Depth and Type of Fill: \_\_\_\_\_  
 Source of Fill: \_\_\_\_\_  
 Bentonite Plugs: From \_\_\_\_\_ to \_\_\_\_\_ From \_\_\_\_\_ to \_\_\_\_\_

Wells other than Bored Wells  
 Casing removed, Y or N? \_\_\_\_\_  
 Depth to which casing was removed: \_\_\_\_\_  
 Applicable, depth(s), and type of gravel/sand fill: \_\_\_\_\_  
 Source of gravel or sand: \_\_\_\_\_  
 Cement: From \_\_\_\_\_ to \_\_\_\_\_ From \_\_\_\_\_ to \_\_\_\_\_

Method of permanently marking location:  
 Installed watertight top  
 Suggest setting pump @ approx. *100* ft.


Contractor

Lee McMillin  
Superior Home Builder  
Shackelford Well Estate #2  
Stafford  
off 616

109 Shackelford Well Road Drillers Log

Depth Description of Formation or Sediment Remarks

0	10	Red Clay
10	25	Brown Shale
25	200	Grey Granite

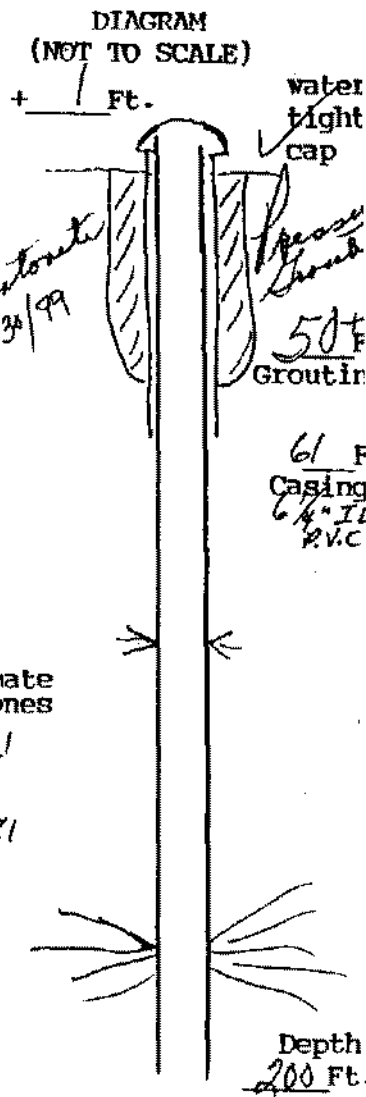

(Use additional Sheets if necessary)

I certify that the information contained here is true and that this well was installed and constructed in accordance with the permit and further that the well complies with all applicable state and local regulations, ordinances and laws.

Name JOHN L. DANIELSON, JR., INC.  
Address 4616 HOOD DRIVE  
FREDERICKSBURG, VIRGINIA 22408  
Phone (703) 898-6025 / 898-9355

Drillers Signature John L. Danielson, Pres.  
Date 1/30/99 Representing JOHN L. DANIELSON, JR., INC.

Virginia Contractors Licence Number CLASS A 2701 014084A II/II WVC