

James C. Sullivan
27 Richard Jerry Rd.
Fredericksburg, Va 22405
752-2860

Commonwealth of Virginia
Uniform Water Well Completion Report

Owner Stansbury L. Harding
Address 1555 Warrenton Road
Hartwood, Va. 22406
Phone 752-4371
Location #724 - Clark Patten Rd.
17 → L on 724 / 700' to House on R.
Well Classification IIIA IIIB IIIC IV
* Well Data *

Tax Map ID 35-86 B
VDH Permit W-93-171
VWCB Permit _____
VWCB ID _____
County Stafford
6/16/93 Daniel Joseph
6/17/93 JDD/okp

General Information

Drilling Method Cauger - Boring Rig Date Completed 7/16/93 Total Depth of Well 49
Depth to Bedrock On Rock Yield 23 GPM @ 20' static Length of Test _____
Static Water Level 20 Stabilized Water Level 40 Natural Flow (Rate) _____
Well Disinfected (Y or N) On Rock Disinfectant Used _____ Amount Used _____
Casing Water rose 3 ft in 30 minutes @ time of installation
24" Curborg Holds approx 23.5 gal. of water per ft.
From 1 To 49 From _____ To _____
Size 24" Material Concrete Size _____ Material _____
Weight/Schedule _____ Weight/Schedule _____
Bored through casing formation from 20 to 30 ft.
On Rock

Gravel Pack From 20 To 23 7/24/93 From _____ To _____ From _____ To _____
Hole size 31" from 0 to 20 ft. 29" from 20 to 49 ft. " from _____ to _____ ft.
Grout From 0 To 20 7/27/93 From _____ To _____ From _____ To _____
Bore Hole Size 39" Bore Hole Size _____ Bore Hole Size _____
Type 1-2 Mix Type _____ Type _____
Method Poured Method _____ Method _____

Water Zones or Screened Intervals

From 20 To 25 From _____ To _____ From _____ To _____
Mesh Size _____ Diam _____ Mesh Size _____ Diam _____ Mesh Size _____ Diam _____
From _____ To _____ From _____ To _____ From _____ To _____
Mesh Size _____ Diam _____ Mesh Size _____ Diam _____ Mesh Size _____ Diam _____

* Use Data *

Private Well: Domestic Agricultural _____ Industrial _____ Monitoring _____
Public Well: Community _____ Non Community _____

* Abandonment Information *

Bored or Oug Wells
Casing Removed, Y or N? _____
If Y, Depth to which casing was removed: _____
Depth and Type of Fill: _____
Source of Fill: _____
Bentonite Plugs From _____ to _____ From _____ to _____
Wells other than Bored Wells
Casing removed, Y or N? _____
Depth to which casing was removed: _____
Applicable, depth(s), and type of gravel/sand fill: _____
Source of gravel or sand: _____
Cement: From _____ to _____ From _____ to _____
Method of permanently marking location: _____
Installed watertight top concrete "Shoobar" Top
Suggest setting pump @ approx. 5 ft. off bottom


George Sullivan

Stagsburg Harding

Stefford - Clark Station Rd


17 → L. on 724 - 400' to House on Right
Drillers Log

Depth Description of Formation or Sediment Remarks

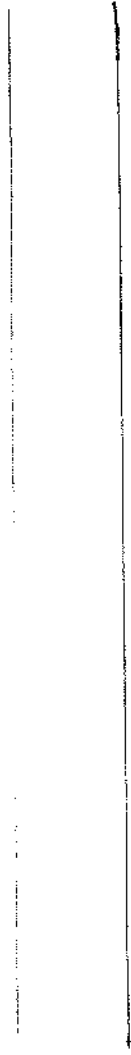

Bored Well

DIAGRAM
(NOT TO SCALE)

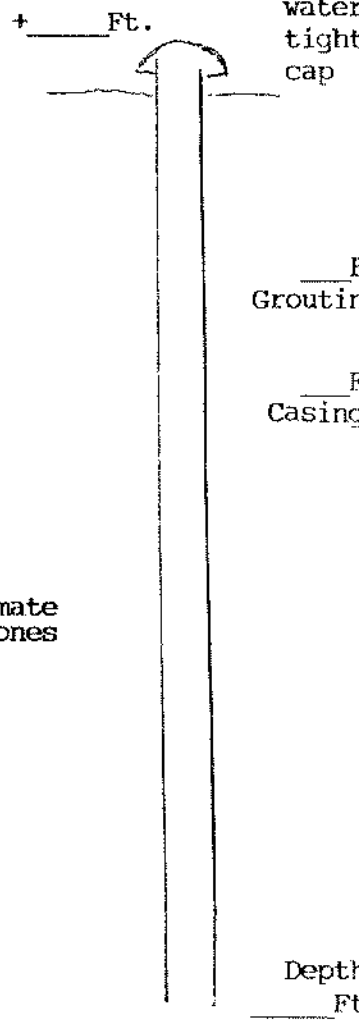

Approximate
Water Zones

(User additional Sheets if necessary)

I certify that the information contained here is true and that this well was installed and constructed in accordance with the permit and further that the well complies with all applicable state and local regulations, ordinances and laws.

Name JOHN L. DANIELSON, JR., INC.
Address 4616 HOOD DRIVE
FREDERICKSBURG, VIRGINIA 22408
Phone (703) 898-6025 / 898-9355

Drillers Signature Anna M. Danielson Pres.
Date 8/5/93 Representing JOHN L. DANIELSON, JR., INC.
(Well Drilling)

Virginia Contractors License Number CLASS A 2701 014084A H/H WWC