

Commonwealth of Virginia  
 069 W. 22405 Uniform Water Well Completion Report

Owner Larry Beach  
 Address 433 Ridgemore Street  
 Phone \_\_\_\_\_  
 Location "Beach Family" #3 Stafford  
\*17 -> \*724 -> Joshua Court on left - @ Circle Six

Tax Map ID 35-68D-72-3  
 VDH Permit WS-91-226  
 WWCB Permit \_\_\_\_\_  
 WWCB ID \_\_\_\_\_  
 County Stafford  
10/19/91 Rob Snyder  
10/24/91 TT Thompson

\* Well Data \*

General Information  
 Drilling Method Air Rotary  
 Depth to Bedrock \_\_\_\_\_  
 Static Water Level 40  
 Well Disinfected (Y or N) \_\_\_\_\_

Date Completed 9/29/92 9/30/92  
 Yield 6 (GPM)  
 Stabilized Water Level \_\_\_\_\_  
 Disinfectant Used \_\_\_\_\_

Total Depth of Well 240  
 Length of Test THR  
 Natural Flow (Rate) \_\_\_\_\_  
 Amount Used \_\_\_\_\_

Casing  
 From +1 To 104  
 Size 6 1/4 Material P.V.C.  
 Weight/Schedule SDR 27

From 90 To 200  
 Size 4 Material P.V.C.  
 Weight/Schedule Sch. 40

From 220 To 240  
 Size 4 Material P.V.C.  
 Weight/Schedule Schedule 40

Gravel Pack  
 From \_\_\_\_\_ To \_\_\_\_\_  
 Hole size \_\_\_\_\_  
 Grout 10" from 0 to 104 ft.  
 From 0 To 50+  
 Bore Hole Size 10"  
 Type Bentonite 9/30/92  
 Method Pressure Grouting

From \_\_\_\_\_ To \_\_\_\_\_  
 Hole size \_\_\_\_\_  
 Grout 1/8" from 104 to 240 ft.  
 From \_\_\_\_\_ To \_\_\_\_\_  
 Bore Hole Size \_\_\_\_\_  
 Type \_\_\_\_\_  
 Method \_\_\_\_\_

From \_\_\_\_\_ To \_\_\_\_\_  
 Hole size \_\_\_\_\_  
 Grout \_\_\_\_\_  
 From \_\_\_\_\_ To \_\_\_\_\_  
 Bore Hole Size \_\_\_\_\_  
 Type \_\_\_\_\_  
 Method \_\_\_\_\_

Water Zones or Screened Intervals  
 From 200 To 220  
 Mesh Size .020 Diam 4" P.V.C.  
 From \_\_\_\_\_ To \_\_\_\_\_  
 Mesh Size \_\_\_\_\_ Diam \_\_\_\_\_

From 120 To 121  
 Mesh Size \_\_\_\_\_ Diam \_\_\_\_\_  
 From 230 To 231  
 Mesh Size \_\_\_\_\_ Diam \_\_\_\_\_

From \_\_\_\_\_ To \_\_\_\_\_  
 Mesh Size \_\_\_\_\_ Diam \_\_\_\_\_  
 From \_\_\_\_\_ To \_\_\_\_\_  
 Mesh Size \_\_\_\_\_ Diam \_\_\_\_\_

\* Use Data \*

Private Well: Domestic  Agricultural \_\_\_\_\_ Industrial \_\_\_\_\_ Monitoring \_\_\_\_\_  
 Public Well: Community \_\_\_\_\_ Non Community \_\_\_\_\_

\* Abandonment Information \*

Bored or Dug Wells  
 Casing Removed, Y or N? \_\_\_\_\_  
 If Y, Depth to which casing was removed: \_\_\_\_\_  
 Depth and Type of Fill: \_\_\_\_\_  
 Source of Fill \_\_\_\_\_  
 Bentonite Plugs: From \_\_\_\_\_ to \_\_\_\_\_ From \_\_\_\_\_ to \_\_\_\_\_

Wells other than Bored Wells  
 Casing removed, Y or N? \_\_\_\_\_  
 Depth to which casing was removed: \_\_\_\_\_  
 Applicable, depth(s), and type of gravel/sand fill: \_\_\_\_\_  
 Source of gravel or sand: \_\_\_\_\_  
 Cement: From \_\_\_\_\_ to \_\_\_\_\_ From \_\_\_\_\_ to \_\_\_\_\_


Method of permanently marking location: Installed watertight top  
 Suggest setting pump @ approx. 220ft.

W. Clifford & Son  
 9010 GREENWICH DRIVE

*Stop off 724*  
 \*17 → 724 → Joshua Court - Cul de Sac  
 Drillers Log

Depth	Description of Formation or Sediment	Remarks
0	10	Sandy Red Clay
10	76	Brown Clay with Mica
76	104	Soft Brown Shale
104	120	Brown Rock
120	240	Light & Dark grey Rock

DIAGRAM  
 (NOT TO SCALE)  
 + 1 Ft.

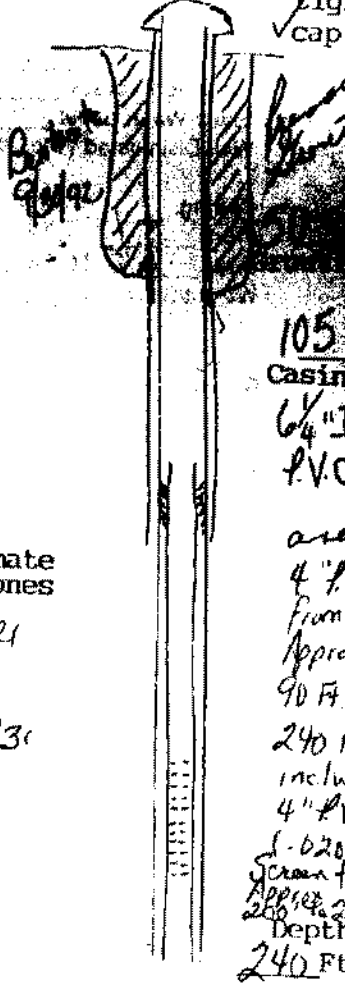

Approximate  
 Water Zones  
 120 to 121  
 and  
 230 to 231

(User additional Sheets if necessary)

I certify that the information contained here is true and that this well was installed and constructed in accordance with the permit and further that the well complies with all applicable state and local regulations, ordinances and laws.

Name JOHN L. DANIELSON, JR., INC.  
 Address 4616 HOOD DRIVE  
FREDERICKSBURG, VIRGINIA 22408  
 Phone (703) 898-6025 / 898-9355

Drillers Signature *John L. Danielson*  
 Date 9/20/92 Representing JOHN L. DANIELSON, JR., INC.

Virginia Contractors License Number \_\_\_\_\_