

Uniform Water Well Completion Report

36-63-16

Owner Janchild Development - Bender
 Address 138 Graham Park Rd.
Dunsmuir, Va: 22026
 Phone 1-703-1226-5537
 Location Waters Edge Sect 1 Lot "b" #651
Intersection of Kelloog Mill Rd -651 & Fire Trail Lane

Tax Map ID 36A-1-6
 VDH Permit _____
 VWCB Permit _____
 VWCB ID _____
 County Stafford
5-18-90 Richard Smith
5-30-90 T.T. Thompson

* Well Data *

General Information

Drilling Method Air Rotary
 Depth to Bedrock 80
 Static Water Level 40
 Well Disinfected (Y or N) _____

Date Completed 10/8/92
 Yield 20 (GPM)
 Stabilized Water Level 140
 Disinfectant Used _____

Total Depth of Well 180
 Length of Test 1 Hr
 Natural Flow (Rate) _____
 Amount Used _____

Casing

From +1 To 80
 Size 6 1/4 Material P.V.C.
 Weight/Schedule SDR 21

From 80 To 100
 Size 6 1/4 Material P.V.C.
 Weight/Schedule SDR 21

From 95 and 140
 To 180
 Size 4" Material P.V.C.
 Weight/Schedule Schedule 40

Gravel Pack

From _____ To _____

From _____ To _____

From _____ To _____

Hole size 10" from 0 to 99 ft.

6 1/4" from 99 to 180 ft.

_____ " from _____ to _____ ft.

Grout From 0 To 50+

From _____ To _____

From _____ To _____

Bore Hole Size 10"

Bore Hole Size _____

Bore Hole Size _____

Type Bentonite

Type _____

Type _____

Method Pressure Grouting

Method _____

Method _____

Water Zones or Screened Intervals

From 140 To 160

Approx Water Zones

From 141 To 142

From _____ To _____

Mesh Size .020 Diam 4"

Mesh Size _____ Diam _____

Mesh Size _____ Diam _____

From _____ To _____

From 162 To 163

From _____ To _____

Mesh Size _____ Diam _____

Mesh Size _____ Diam _____

Mesh Size _____ Diam _____

* Use Data *

Private Well: Domestic Agricultural _____ Industrial _____ Monitoring _____
 Public Well: Community _____ Non Community _____

* Abandonment Information *

Bored or Dug Wells

Casing Removed, Y or N?: _____
 If Y, Depth to which casing was removed: _____
 Depth and Type of Fill: _____
 Source of Fill: _____
 Bentonite Plugs: From _____ to _____ From _____ to _____

Wells other than Bored Wells

Casing removed, Y or N?: _____
 Depth to which casing was removed: _____
 Applicable, depth(s), and type of gravel/sand fill: _____
 Source of gravel or sand: _____
 Cement: From _____ to _____ From _____ to _____

Method of permanently marking location: _____

Installed watertight top
 Suggest setting pump @ approx. 140 ft.

*You will encounter 4" casing @ approx. 95 ft.
 Suggest keeping torque arrestors & centralizers out of 4" casing.*

John Jacobe / Atlantis Ltd
Bender


Water's Edge #6
Stafford #651

Drillers Log

Depth Description of Formation or Sediment Remarks

0	10	Sandy Red Clay
10	30	Micaceous formation / Red
30	70	Micaceous formation / Brown
70	80	Soft Brown Shale
80	180	Soft Blue Shale

DIAGRAM
(NOT TO SCALE)

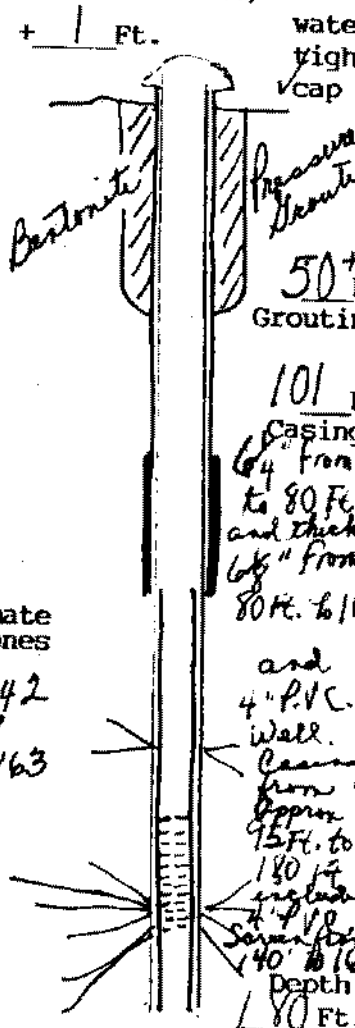

Approximate Water Zones
141 to 142 and 162 to 163

(User additional Sheets if necessary)

I certify that the information contained here is true and that this well was installed and constructed in accordance with the permit and further that the well complies with all applicable state and local regulations, ordinances and laws.

Firm JOHN L. DANIELSON, JR., INC.
Address 4616 HOOD DRIVE
FREDERICKSBURG, VIRGINIA 22408
Phone (703) 898-6025 / 898-9355

Drillers Signature *John L. Danielson*
Date 10/9/92 Representing JOHN L. DANIELSON, JR., INC.

Virginia Contractors License Number