

Commonwealth of Virginia  
Uniform Water Well Completion Report

Owner Fairchild Devel. Corp.  
Address 721 Belle Plains Rd.  
Falmouth, VA  
Phone 372-6456  
Location Lot #15 - Waters Edge

Tax Map ID 36-A-2-15  
VDH Permit 189-90-127  
VWCB Permit \_\_\_\_\_  
VWCB ID \_\_\_\_\_  
County Stafford

\* Well Data \*

General Information

Drilling Method Air Rotary  
Depth to Bedrock 70  
Static Water Level 40  
Well Disinfected (Y or N) N

Date Completed 2-17-92  
Yield 120 (GPM)  
Stabilized Water Level \_\_\_\_\_  
Disinfectant Used \_\_\_\_\_

Total Depth of Well 180  
Length of Test 2 hr  
Natural Flow (Rate) -  
Amount Used \_\_\_\_\_

Casing

From +1 to 100  
Size 6 3/4 Material PVC  
Weight/Schedule Sch 40

From \_\_\_\_\_ to \_\_\_\_\_  
Size \_\_\_\_\_ Material \_\_\_\_\_  
Weight/Schedule \_\_\_\_\_

From \_\_\_\_\_ to \_\_\_\_\_  
Size \_\_\_\_\_ Material \_\_\_\_\_  
Weight/Schedule \_\_\_\_\_

Gravel Pack

From \_\_\_\_\_ to \_\_\_\_\_

From \_\_\_\_\_ to \_\_\_\_\_

From \_\_\_\_\_ to \_\_\_\_\_

Grout

From 50 to 0  
Bore Hole Size 11"  
Type Neat  
Method Pressure

From 0 to 100  
Bore Hole Size 11"  
Type \_\_\_\_\_  
Method \_\_\_\_\_

From 100 to 180  
Bore Hole Size 6"  
Type \_\_\_\_\_  
Method \_\_\_\_\_

Water Zones or Screened Intervals

From 150 to 155  
Mesh Size \_\_\_\_\_ Diam. \_\_\_\_\_  
From \_\_\_\_\_ to \_\_\_\_\_  
Mesh Size \_\_\_\_\_ Diam. \_\_\_\_\_

From 160 to 165  
Mesh Size \_\_\_\_\_ Diam. \_\_\_\_\_  
From \_\_\_\_\_ to \_\_\_\_\_  
Mesh Size \_\_\_\_\_ Diam. \_\_\_\_\_


From \_\_\_\_\_ to \_\_\_\_\_  
Mesh Size \_\_\_\_\_ Diam. \_\_\_\_\_  
From \_\_\_\_\_ to \_\_\_\_\_  
Mesh Size \_\_\_\_\_ Diam. \_\_\_\_\_

\* Use Data \*

Private Well: Domestic X Agricultural \_\_\_\_\_ Industrial \_\_\_\_\_ Monitoring \_\_\_\_\_  
Public Well: Community \_\_\_\_\_ Non Community \_\_\_\_\_

(Use additional sheets if necessary)

Depth	Description of Formation or Sediment	Remarks
0-10	Clay	Orange
10-70	Clay	brown
70-100	Rock	Soft brown
100-130	Rock	Soft w/brown void (110-115)
130-150	Rock	Soft blue granite
150-155	hole	broken void w/quartz
155-180	Rock	blue granite

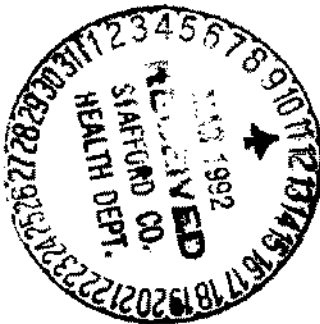

I certify that the information contained here is true and that this well was installed and constructed in accordance with the permit and further that the well complies with all applicable state and local regulations, ordinances and laws.

**Drilling**

**Contractor** Van's Const. Co., Inc.®

**Address** PO Box 3306  
Fredericksburg, VA 22402

**Phone** 373-7502

**Drillers Signature** W. R. Van Hay

**Date** 2-18-92

**Representing** Van's Const. Co., Inc.

**Virginia Contractors License Number** 2701018610