

COMMONWEALTH OF VIRGINIA
WATER WELL COMPLETION REPORT

BWCM No. _____

(Certification of Completion/County Permit)

Michael Mc Gee
P.O. Box 471

36-9

Control Board
Hamilton St.
Va. 23230

SWCB Permit _____
County Permit _____

Certification of inspecting official:
This well does _____ does not _____
meet code/low requirements.
S. _____
Date _____

For Office Use

County/City _____

County/City Stamp

Virginia Plane Coordinates
N _____
E _____
Latitude & Longitude
N _____
W _____
Topo. Map No. 1832
Elevation _____ ft.
Formation Q
Lithology _____
River Basin _____
Province _____
Type Logs D. L.
Cuttings N. A.
Water Analysis _____
Aquifer Test _____

Owner For Sale
Well Designation or Number _____
Address _____
Phone _____
Drilling Contractor John L. Danielson, Jr., Inc.
Address 4616 Hood Drive
Fredericksburg, Virginia 22401
Phone (703) 898-6025

Tax Map I.D. No. _____
Subdivision Mc Gee
Section _____
Block _____
Lot 9
Class Well: I _____, IIA _____
IIB _____, IIIA _____, IIIB
IIIC _____, IIID _____, IIIE _____

WELL LOCATION: 3/10 (feet/miles South direction) of intersection of 666 & 651
and 30 (feet/miles West direction) of # 651
(If possible please include map showing location marked)
Water rose 3 ft. in 30 min. @ time of installation
24" I.D. casing holds 35.5 gal. of water per foot.
Date started 12/26/86 Date completed 12/26/86 Type rig Boring Rig


Approximate Drawdown 20 ft.

WELL DATA: New Reworked _____ Deepened _____
Total depth 62 ft.
Depth to bedrock _____ ft.
Hole size (Also include reamed zones)
• 39 inches from 0 to 20 ft.
• 29 inches from 20 to 62 ft.
Casing size (I.D.) and material
• 24 inches from +1 to 62 ft.
Material cement concrete casing
Wt. per foot _____ or wall thickness _____ in.
Screen size and mesh for each zone (where applicable)
• Mesh size _____ Type _____
Gravel pack
• From Bottom to 37 ft.
Grout
• From Top to 25 ft. Type 1 part sand 2 part cement
• From _____ to _____ ft. Type _____

2. WATER DATA • Water temperature _____
• Static water level (unpumped level measured) 20
• Stabilized measured pumping water level 40
• Stabilized yield 23 gpm after 10 min. of installation
Natural Flow: Yes _____ No Flow rate _____ g
Comment on quality _____
3. WATER ZONES: From 20 To 30
From _____ To 40 From _____ To _____
4. USE DATA:
Type of use: Drinking Livestock Watering _____
Irrigation _____ Food processing _____ Household
Manufacturing _____ Fire safety _____ Cleaning _____
Recreation _____ Aesthetic _____ Cooling or heating _____
Injection _____ Other _____
• Type of facility: Domestic Public water supply _____
Public institution _____ Farm _____ Industry _____
Commercial _____ Other _____
5. PUMP DATA: Type _____ Rated H.P. _____
• Intake depth _____ Capacity _____ at _____ head _____
6. WELLHEAD: Type well seal _____
Pressure tank _____ gal. Loc. _____
Sample tap _____ Measurement port _____
Well vent _____ Pressure relief valve _____
Gate valve _____ Check valve (when required) _____
Electrical disconnect switch on power supply _____
7. DISINFECTION: Well disinfected _____ yes _____ no _____
Date _____ Disinfectant used _____
Amount _____ Hours used _____
8. ABANDONMENT (where applicable) • yes _____ no _____
Casing pulled yes _____ no _____ not applicable _____
Plugging grout From _____ to _____ material _____
Pump installation through Mc Gee

Underwater and wells for every...
over the well is completed, on...
report, full data from any aquifer...
analysis, and copies of any aquifer...
State permits to drill, any the required...
Health Department requirements. State the...

DANIELSON, JR., INC.
Drilled & Bored Wells
4616 Hood Drive
FREDERICKSBURG, VIRGINIA 22401

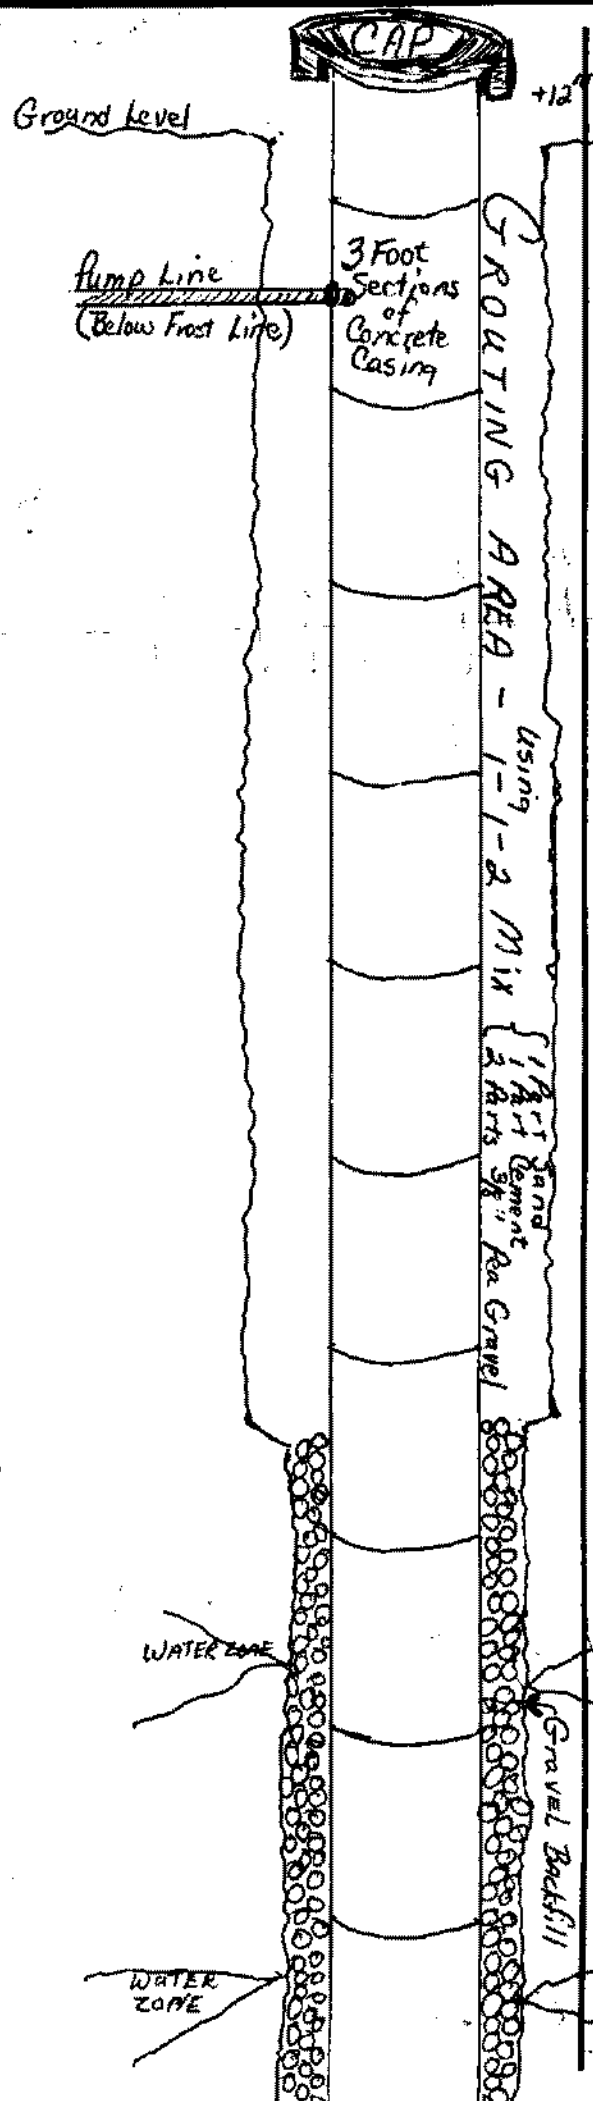

Phone 898-WELL or 898-6025