


John Bradley
Crestwood II (3rd Cardinal Drive)
Stafford
 #1652

• Drillers Log •

Depth Description of Formation or Sediment Remarks

| | | |
|-----|-----|--|
| 0 | 10 | Red Clay |
| 10 | 50 | Micaceous formation/Red |
| 50 | 75 | Micaceous formation/Brown |
| 75 | 120 | Brown Shale (set 4" P.V.C. screen below due to the softening of the formation. 1/9/95) |
| 120 | 300 | Blue Shale |

DIAGRAM (NOT TO SCALE)

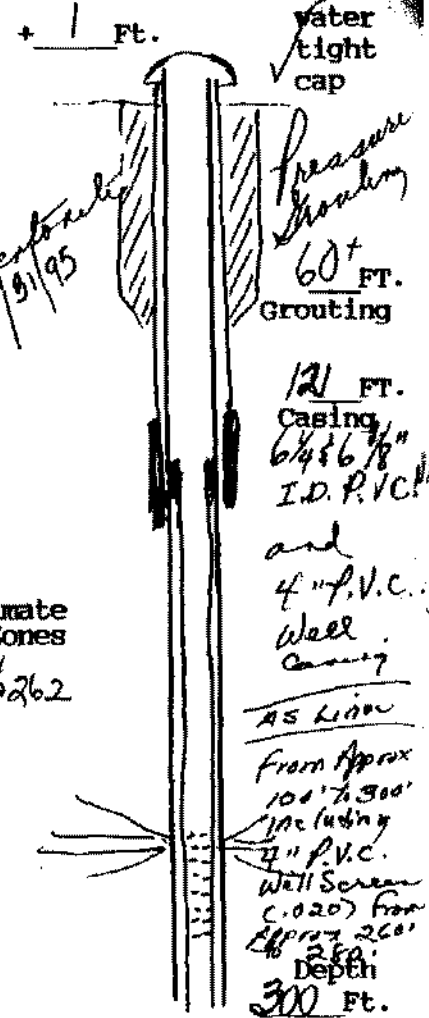

Approximate Water Zones

261 to 262



(User additional Sheets if necessary)

I certify that the information contained here is true and that this well was installed and constructed in accordance with the permit and further that the well complies with all applicable state and local regulations, ordinances and laws.

Name JOHN L. DANIELSON, JR., INC.
 Address 4616 HOOD DRIVE
FREDERICKSBURG, VIRGINIA 22408
 Phone (703) 898-6025 / 898-9355

Drillers Signature John L. Danielson, Jr.
 Date 1/21/95 Representing JOHN L. DANIELSON, JR., INC.

Virginia Contractors License Number CLASS A 2701 014084A H/H WWC

Health
 Environmental
 Department
 of
 Community/Corporation
 9433 Lombard
 Address: