

COMMONWEALTH OF VIRGINIA
WATER WELL COMPLETION REPORT
(Certification of Completion/County Permit)

• BWCM No. 36-59A

Water Control Board
 P.O. Box 11143
 2111 North Hamilton St.
 Richmond, Va. 23230

County/City STAFFORD

County/City Stamp

• Virginia Plane Coordinates
 _____ N
 _____ E
 Latitude & Longitude
 _____ N
 _____ W

• Topo. Map No. _____
 • Elevation _____ ft.
 • Formation _____
 • Lithology _____
 • River Basin _____
 • Province _____
 • Type Logs _____
 • Cuttings _____
 • Water Analysis _____
 • Aquifer Test _____

• Owner JENNIFER WIGHTSWORTH
 • Well Designation or Number SWP-96-346
 Address 429 Kellogg Mill Rd.
741 South Va 22406
 Phone _____

• Drilling Contractor R. L. CURTIS WELL DRILLING CO.
 Address 5069 SUMERDUCK RD.
SUMERDUCK, VA 22742
 Phone 540-439-8377

SWCB Permit _____
 County Permit _____

Certification of inspecting official:
 This well does _____ does not _____
 meet code/flow requirements.
 S. _____
 Date _____

For Office Use

Tax Map I.D. No. 36-59A
 Subdivision _____
 Section _____
 Block _____
 Lot _____
 Class Well: I _____ IIA _____
 IIB _____ IIIA _____ IIIB
 IIIC _____ IIID _____ IIIE _____

WELL LOCATION: _____ (feet/miles _____ direction) of _____
 and _____ feet/miles _____ (direction) of _____
 (if possible please include map showing location marked)

Date started 8/17/98 • Date completed 8/17/98 Type rig DRR

1. WELL DATA: New Reworked _____ Deepened _____

• Total depth 125 ft.
 • Depth to bedrock 80 ft.

• Hole size (Also include reamed zones)
 • 10 inches from 0 to 90 ft.
 • 6 inches from 90 to 125 ft.
 • _____ inches from _____ to _____ ft.

• Casing size (I.D.) and material
 • 6 1/2 inches from 0 to 90 ft.
 Material PLASTIC
 Wt. per foot 4 or wall thickness 2 1/4 in.
 • _____ inches from _____ to _____ ft.
 Material _____
 Wt. per foot _____ or wall thickness _____ in.
 • _____ inches from _____ to _____ ft.
 Material _____
 Wt. per foot _____ or wall thickness _____ in.

• Screen size and mesh for each zone (where applicable)
 • _____ inches from _____ to _____ ft.
 • Mesh size _____ Type _____
 • _____ inches from _____ to _____ ft.
 • Mesh size _____ Type _____
 • _____ inches from _____ to _____ ft.
 • Mesh size _____ Type _____
 • _____ inches from _____ to _____ ft.
 • Mesh size _____ Type _____

• Gravel pack
 • From _____ to _____ ft.
 • From _____ to _____ ft.

• Grout
 • From 0 to 50+ ft., Type PRESSURE
 • From _____ to _____ ft., Type _____

2. WATER DATA • Water temperature _____ of _____
 • Static water level (unpumped level-measured) 28 ft.
 • Stabilized measured pumping water level 124 ft.
 • Stabilized yield 20 gpm after 2 hours
 Natural Flow: Yes _____ No _____ flow rate _____ gpm
 Comment on quality _____

3. WATER ZONES: From _____ To _____
 From _____ To _____ From _____ To _____
 From _____ To _____ From _____ To _____

4. USE DATA:
 Type of use: Drinking Livestock Watering _____
 Irrigation _____ Food Processing _____ Household
 Manufacturing _____ Fire safety _____ Cleaning _____
 Recreation _____ Aesthetic _____ Cooling or heating _____
 Injection _____ Other _____

• Type of facility: Domestic Public water supply _____
 Public institution _____ Farm _____ Industry _____
 Commercial _____ Other _____

5. PUMP DATA: Type _____ • Rated H.P. _____
 • Intake depth _____ • Capacity _____ at _____ head

6. WELLHEAD: Type well seal _____
 Pressure tank _____ gal. Loc. _____
 Sample tap _____ Measurement port _____
 Well vent _____ Pressure relief valve _____
 Gate valve _____ Check valve (when required) _____
 Electrical disconnect switch on power supply _____

7. DISINFECTION: Well disinfected _____ yes _____ no _____
 Date _____ Disinfectant used _____
 Amount _____ Hours used _____

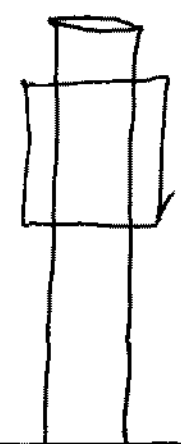
8. ABANDONMENT (where applicable) • yes _____ no _____
 Casing pulled yes _____ no _____ not applicable _____
 Plugging grout From _____ to _____ material _____

Owner Jennifer Wigglesworth

BWCA No. _____

181 X08 00 P.O. BOX 181 OLD GREENSBORO, NC

9. State law requires submitting to the Virginia State Water Control Board information about groundwater and wells for every well made in this state intended for water, or any other non-exempt well. This information must be submitted whether the well is completed, on standby, or abandoned. Information required includes: an accurately and completely prepared water well completion report, full data from any aquifer pumping tests, cuttings taken at ten foot intervals (unless exemption is secured), the results of any chemical analyses, and copies of any geophysical logs. Quarterly pumpage and use reports are required from owners of public supply and industrial wells. County or State permits to drill may be required in some parts of the state. Some counties require submission of a water well completion report. The Virginia State Health Department requires a water well completion report for public supply wells.

10. DRILLERS LOG (use additional Sheets if necessary)			11. Drilling Time (Min.)	12. DIAGRAM OF WELL CONSTRUCTION (with dimensions)
DEPTH (feet) From	To	TYPE OF ROCK OR SOIL (color, material, fossils, hardness, etc.)		
0	80	Red soil		<p>WELL 125 FT CASING 90 FT CASING GROUT 50 FT WATER TIGHT CAP</p> 
80	125	Blue stone		



13. Well lot dedicated? _____ Size _____ ft. X _____ ft., Well house? _____
 Distance to nearest pollutant source _____ ft., Type _____
 Distance to nearest property line _____ ft., Building _____ ft.

14. WATER SERVICE PIPE: Checked under _____ p. s. i. for _____
 minutes. Pipe size _____ inches, Material _____
 Installer _____
 Date _____

15. I certify that the information contained herein is true and correct and that this well and/or system has been installed and constructed in accordance with the requirements for well construction as specified in compliance with appropriate county or independent city ordinances and the laws and rules of the Commonwealth of Virginia.

State Water Control Board Regional Offices

Valley Reg. Off.
116 North Main Street
P. O. Box 268
Bridgewater, Va. 22812
703-828-2595

Piedmont Reg. Off.
4010 West Broad Street
P. O. Box 8616
Richmond, Va. 23230
804-257-1006

Southwest Reg. Off.
408 East Main Street
P. O. Box 476
Abingdon, Va. 24210
703-628-5183

Tidewater Reg. Off.
287 Pembroke Office Park
Suite 310 Pembroke No. 2
Va. Beach, Va. 23462
804-499-8742

West Central Reg. Off.
Executive Park
3312 Peters Creek Road
Roanoke, Va. 24019
703-982-7432

Northern Virginia Reg. Off.
5515 Cherokee Avenue
Suite 404
Alexandria, Va. 22312
703-750-9111

Signature Jerry Coates (Seal) Date 8/17/98
 (Well driller or authorized person) License No. 029220R