

Commonwealth of Virginia  
Uniform Water Well Completion Report

Owner Ward Corp.  
 Address 1300 Piccadilly Dr.  
Rockville MD  
 Phone (301) 946-9208  
 Location The Willows Sec. 10/Block IV Lot #32

Tax Map ID 31B-4-32  
 VDH Permit SWP-99-736  
 VWCB Permit \_\_\_\_\_  
 VWCB ID \_\_\_\_\_  
 County Stafford

\* Well Data \* CLASS III B

General Information  
 Drilling Method Air Rotary  
 Depth to Bedrock 41'  
 Static Water Level 35'  
 Well Disinfected (Y or N) N

Date Completed 4/19/00  
 Yield 3 (GPM)  
 Stabilized Water Level \_\_\_\_\_  
 Disinfectant Used \_\_\_\_\_

Total Depth of Well 500'  
 Length of Test 1 hr  
 Natural Flow (Rate) N  
 Amount Used \_\_\_\_\_

Casing  
 From 4 1/2' To 54 1/2'  
 Size 6 1/4" Material PVC  
 Weight/Schedule 3.441 @ 100 ft.  
.250 wall  
1 water tight cap

From \_\_\_\_\_ To \_\_\_\_\_  
 Size \_\_\_\_\_ Material \_\_\_\_\_  
 Weight/Schedule \_\_\_\_\_

From \_\_\_\_\_ To \_\_\_\_\_  
 Size \_\_\_\_\_ Material \_\_\_\_\_  
 Weight/Schedule \_\_\_\_\_

Gravel Pack  
 From \_\_\_\_\_ To \_\_\_\_\_

From \_\_\_\_\_ To \_\_\_\_\_

From \_\_\_\_\_ To \_\_\_\_\_

Grout  
 From 54 1/2' To 0  
 Bore Hole Size 10" x 54 1/2'  
 Type Bentonite E-2 seal  
 Method pressure grout from bottom to top

From \_\_\_\_\_ To \_\_\_\_\_  
 Bore Hole Size \_\_\_\_\_  
 Type \_\_\_\_\_  
 Method \_\_\_\_\_

From \_\_\_\_\_ To \_\_\_\_\_  
 Bore Hole Size \_\_\_\_\_  
 Type \_\_\_\_\_  
 Method \_\_\_\_\_

Water Zones or Screened Intervals  
 From 386 To 388  
 Mesh Size \_\_\_\_\_ Diam \_\_\_\_\_  
 From \_\_\_\_\_ To \_\_\_\_\_  
 Mesh Size \_\_\_\_\_ Diam \_\_\_\_\_

From \_\_\_\_\_ To \_\_\_\_\_  
 Mesh Size \_\_\_\_\_ Diam \_\_\_\_\_

\* Use Data \*

Private Well: Domestic  Agricultural \_\_\_\_\_ Industrial \_\_\_\_\_ Monitoring \_\_\_\_\_  
 Public Well: Community \_\_\_\_\_ Non Community \_\_\_\_\_

\* Abandonment Information \*

Bored or Dug Wells  
 Casing Removed, Y or N? \_\_\_\_\_  
 If Y, Depth to which casing was removed: \_\_\_\_\_  
 Depth and Type of Fill: \_\_\_\_\_  
 Source of Fill \_\_\_\_\_  
 Bentonite Plugs: From \_\_\_\_\_ to \_\_\_\_\_ From \_\_\_\_\_ to \_\_\_\_\_


Wells other than Bored Wells  
 Casing removed, Y or N? \_\_\_\_\_  
 Depth to which casing was removed: \_\_\_\_\_  
 Applicable, depth(s), and type of gravel/sand fill: \_\_\_\_\_  
 Source of gravel or sand: \_\_\_\_\_  
 Cement: From \_\_\_\_\_ to \_\_\_\_\_ From \_\_\_\_\_ to \_\_\_\_\_

Method of permanently marking location: \_\_\_\_\_

Drillers Log

Depth	Description of Formation or Sediment
0-41'	Overburden (clay + silty sand)
41'-500'	sedimentary rock

Remarks NOT to scale water tight

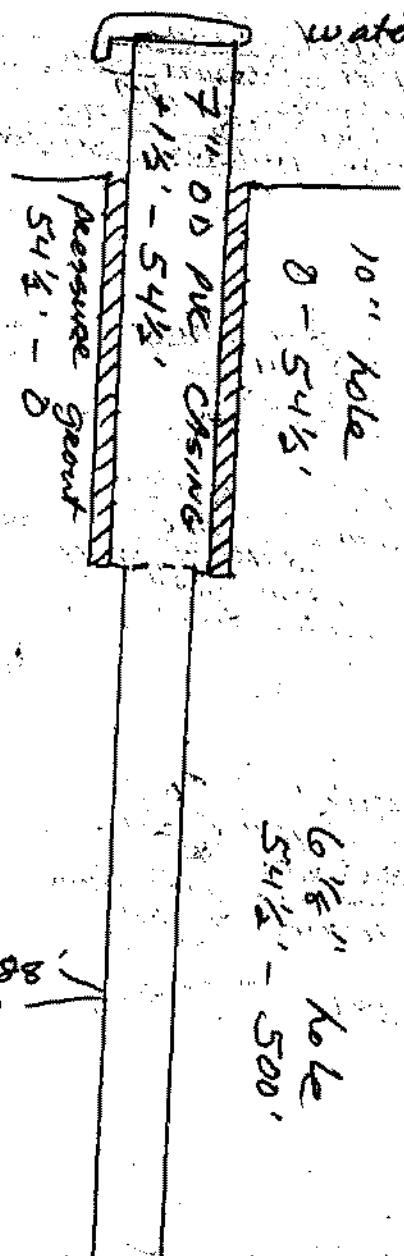

386'-388'  
3 GPM

(User additional Sheets if necessary)

I certify that the information contained here is true and that this well was installed and constructed in accordance with the permit and that the well complies with all applicable state and local regulations, ordinances and laws.

Company: Artesian Water Wells, Inc.  
Address: 11412 Gordon Rd. F. Brg. UT 22407

Phone: (540) 785-8163

Drillers Signature: Wade N. [Signature]  
Date: 4/19/20 Representing: AWWI

Virginia Contractors License Number: 2705-046112