

**Commonwealth of Virginia
Uniform Water Well Completion Report**

Owner Dave Shaker
 Address 8 Darbywood
Stafford Va. 22554
 Phone 371-1415
 Location Wateredge Estates Sect 2 Lot 25
 Well Classification IIIA IIIB ✓ IIIIC IV
 * Well Data *

Tax Map ID 36 A-2-25
 VDH Permit SWT-97-113
 VWCB Permit _____
 VWCB ID _____
 County Stafford
J.F.F.

General Information
 Drilling Method air rotary
 Depth to Bedrock 10'
 Static Water Level 70'
 Well Disinfected (Y or N) _____

Date Completed 7/31/97
 Yield 12 (GPM)
 Stabilized Water Level 140'
 Disinfectant Used _____

Total Depth of Well 200'
 Length of Test approx 1 Hr.
 Natural Flow (Rate) _____
 Amount Used _____

Casing
 From 11' To 76'
 Size 6 1/2" Material P.V.C.
 Weight/Schedule SDR 27

From 70' To 160'
 Size 4" Material P.V.C.
 Weight/Schedule Sch. 40

From 180' To 200'
 Size 4" Material P.V.C.
 Weight/Schedule Sch 40

Gravel Pack
 From _____ To _____
Hole size
10" from 0 to 60 ft.
Grout
 From 0 To 50'
 Bore Hole Size 10"
 Type Bentonite
 Method Pressure Grouting

From _____ To _____
7 1/2" from 60 to 76 ft.
 From _____ To _____
 Bore Hole Size _____
 Type _____
 Method _____

From _____ To _____
6 1/2" from 76 to 200 ft.
 From _____ To _____
 Bore Hole Size _____
 Type _____
 Method _____

Water Zones or Screened Intervals
 From 160 To 180
 Mesh Size 16 Diam 4" (P.V.C.)
 From _____ To _____
 Mesh Size _____ Diam _____

approx water zones
 From 177 To 180
 Mesh Size _____ Diam _____
 From _____ To _____
 Mesh Size _____ Diam _____

From _____ To _____
 Mesh Size _____ Diam _____
 From _____ To _____
 Mesh Size _____ Diam _____

* Use Data *

Private Well: Domestic Agricultural _____ Industrial _____ Monitoring _____
 Public Well: Community _____ Non Community _____

* Abandonment Information *

Bored or Dug Wells
 Casing Removed, Y or N?: _____
 If Y, Depth to which casing was removed: _____
 Depth and Type of Fill: _____
 Source of Fill _____
 Bentonite Plugs: From _____ to _____ From _____ to _____

Wells other than Bored Wells
 Casing removed, Y or N? _____
 Depth to which casing was removed: _____
 Applicable, depth(s), and type of gravel/sand fill: _____
 Source of gravel or sand: _____
 Cement: From _____ to _____ From _____ to _____

Method of permanently marking location: _____
 Installed watertight top


Suggest setting pump @ approx. 160 ft.
 You will encounter 4" casing @ approx. 70 ft.
 Suggest keeping centralizers & torque wrenches out of 4" casing

Deer Shaker
Wateredge Sect 2 Lot 25
Staffed
 #17 → 616 → 651

* Drillers Log *

Depth	Description of Formation or Sediment	Remarks
0	10	Red Clay
10	30	Micaceous formation / Red
30	50	Micaceous formation / Brown
50	76	Brown Shale
76	200	Blue Shale

set 4" P.V.C. Well Casing & Screen.
 as liner - due to the
 softness of the formation

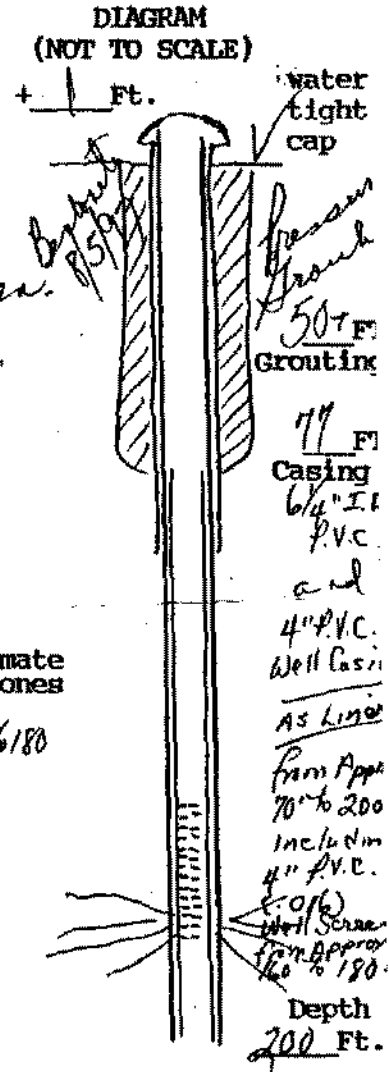

Approximate
Water Zones

177-180

(User additional Sheets if necessary)

I certify that the information contained here is true and that this well was installed and constructed in accordance with the permit and further that the well complies with all applicable state and local regulations, ordinances and laws.

Name JOHN L. DANIELSON, JR., INC.
 Address 4616 HOOD DRIVE
FREDERICKSBURG, VIRGINIA 22408
 Phone 548(208) 898-6025 / 898-9355
 Drillers Signature John L. Danielson, President
 Date 8/97 Representing JOHN L. DANIELSON, JR., INC.
 Virginia Contractors License Number CLASS A 2701 014084A H/H WVC