

**Commonwealth of Virginia
Uniform Water Well Completion Report**

Owner Charles Beech
 Address 200 Crossways Road
Baltimore Va 22406
 Phone 871-1127
 Location Baywood Estates #1 (1/2 Street from Fox Carner Farm)
#17 - 1/2 mile S 651 on left / Kellogg Mill Rd.
 Well Classification IIIA IIIB IIIC IV

Tax Map ID 36-44-1
 VDH Permit WIS-92-363
 VWCB Permit _____
 VWCB ID _____
 County Stafford
12/1/92 Rth Smydman
12/3/92 T T Thompson

* Well Data *

General Information
 Drilling Method Air Rotary Date Completed 8/13/93 Total Depth of Well 260
 Depth to Bedrock 100 Yield 10 (GPM) Length of Test 1 Hr.
 Static Water Level 40 Stabilized Water Level 160 Natural Flow (Rate) _____
 Well Disinfected (Y or N) _____ Disinfectant Used _____ Amount Used _____

Casing
 From +1 To 120 From _____ To _____ From _____ To _____
 Size 6 1/4" Material P.V.C. Size _____ Material _____ Size _____ Material _____
 Weight/Schedule SDR 27 Weight/Schedule _____ Weight/Schedule _____

Gravel Pack
 From _____ To _____ From _____ To _____ From _____ To _____
 Hole size 10" from 0 to 120ft. 6" from 120 to 260ft. " from _____ to _____ft.
 Grout From 0 To 50' From _____ To _____ From _____ To _____
 Bore Hole Size 10" Bore Hole Size _____ Bore Hole Size _____
 Type Bentonite Type _____ Type _____
 Method Pressure Grouting Method _____ Method _____

Water Zones or Screened Intervals
 From 160 To 161 From _____ To _____ From _____ To _____
 Mesh Size _____ Diam _____ Mesh Size _____ Diam _____ Mesh Size _____ Diam _____
 From 240 To 241 From _____ To _____ From _____ To _____
 Mesh Size _____ Diam _____ Mesh Size _____ Diam _____ Mesh Size _____ Diam _____

* Use Data *

Private Well: Domestic Agricultural _____ Industrial _____ Monitoring _____
 Public Well: Community _____ Non Community _____

* Abandonment Information *

Bored or Dug Wells	Wells other than Bored Wells
Casing Removed, Y or N? _____	Casing removed, Y or N? _____
If Y, Depth to which casing was removed: _____	Depth to which casing was removed: _____
Depth and Type of Fill: _____	Applicable, depth(s), and type of gravel/sand fill: _____
Source of Fill _____	Source of gravel or sand: _____
Bentonite Plugs: From _____ to _____ From _____ to _____	Cement: From _____ to _____ From _____ to _____


Method of permanently marking location: _____
 Installed watertight top
 Suggest setting pump @ approx. 180 ft.

11/05

Charles & Janette Beech
Bryant Estates #1

Stafford on left / up from Fox Corner Farm
17 → 616 → 651
Kellogg Mill Rd. * Drillers Log *

Depth	Description of Formation or Sediment	Remarks
0	10	Red Clay
10	100	Brown Sandy Clay
100	120	Soft Brown Rock (Shale)
120	260	Dark Gray Granite

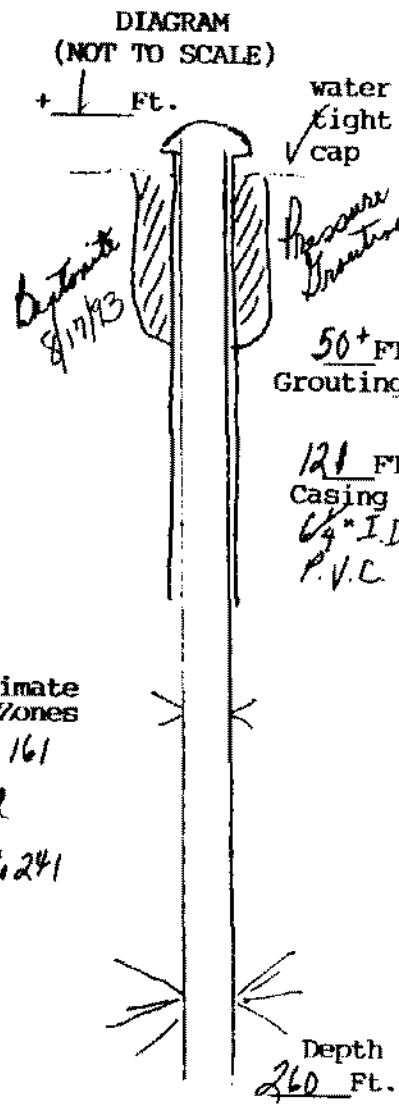

(User additional Sheets if necessary)

I certify that the information contained here is true and that this well was installed and constructed in accordance with the permit and further that the well complies with all applicable state and local regulations, ordinances and laws.

Name JOHN L. DANIELSON, JR., INC.
Address 4616 HOOD DRIVE
FREDERICKSBURG, VIRGINIA 22408
Phone (703) 898-6025 / 898-9355

Drillers Signature John L. Danielson, Jr.
Date 8/12/93 Representing JOHN L. DANIELSON, JR., INC.

Virginia Contractors License Number CLASS A 2701 014084A H/H WMC