

Classical Southern Homes
77 Harrison Road
Fredricksburg, Va 22407
916-9795 F 785-18188
(N. 840-1210)

Commonwealth of Virginia
Uniform Water Well Completion Report

Owner Classical Southern Homes / For Sale
Address _____

Tax Map ID 36-40-20
VDH Permit WS-93-14
VWCB Permit _____
VWCB ID _____

Phone _____
Location Woodwood #20
19 -> 216 -> R on 2652 -> L on Commercial Drive / Dr on Right
Well Classification IIIA IIIB IIIC IV
183C 3/4 A. South of Intersection of 6521 Commercial Drive Well Data

County Stafford
1/22/93 Daniel J. Gandy
1/26/93 J. D. H. H. H.

General Information

Drilling Method Air Rotary
Depth to Bedrock 62
Static Water Level 70
Well Disinfected (Y or N) _____

Date Completed 6/22/93
Yield 7 (GPM)
Stabilized Water Level 280
Disinfectant Used _____

Total Depth of Well 380
Length of Test 1 Hr
Natural Flow (Rate) _____
Amount Used _____

Casing +1
From 0 To 62
Size 6 1/4 Material Steel
Weight/Schedule 13 lb / ft

approx
From 3 To 283
Size 4 Material P.V.C.
Weight/Schedule Sch 40

approx
From 303 To 323
Size 4 Material P.V.C.
Weight/Schedule Sch 40

Gravel Pack

From _____ To _____
Grout Size 10" from 0 to 62 ft.
Grout From 0 To 50'
Bore Hole Size 10"
Type Grout
Method Grout

From _____ To _____
Grout Size 6" from 62 to 380 ft.
Bore Hole Size _____
Type _____
Method _____

From _____ To _____
Grout Size _____ from _____ to _____ ft.
Bore Hole Size _____
Type _____
Method _____

Water Tables or Filtered Intervals

approx
From 283 To 303
Mesh Size .020 Diam 4" P.V.C.
From _____ To _____
Mesh Size _____ Diam _____

From 362 To 361
Mesh Size _____ Diam _____
From _____ To _____
Mesh Size _____ Diam _____

From _____ To _____
Mesh Size _____ Diam _____
From _____ To _____
Mesh Size _____ Diam _____

* Use Data *

Private Well: Domestic Agricultural _____ Industrial _____ Monitoring _____
Public Well: Community _____ Non Community _____

* Abandonment Information *

Bored or Dug Wells
Casing Removed, Y or N? _____
If Y, Depth to which casing was removed: _____
Depth and Type of Fill: _____
Source of Fill: _____
Bentonite Plugs, From _____ to _____ From _____ to _____

Wells other than Bored Wells
Casing removed, Y or N? _____
Depth to which casing was removed: _____
Applicable, depth(s), and type of gravel/sand fill: _____
Source of gravel or sand: _____
Cement: From _____ to _____ From _____ to _____


Method of permanently marking location:
 Installed watertight top
Elevation marking pump @ approx. 300 ft.

Classical Southern Home
 # 20
 S 1046, 104
 6524 Cardinal Drive

Drillers Log

Depth	Description of Formation or Sediment	Remarks
0	10	Red Clay
10	30	Micaceous formation / Red
30	50	Micaceous formation / Brown
50	60	Broken Rock
60	300	Soft Blue Shale
300	380	Blue Granite with holes

Set 4" P.V.C.
 Due to softness
 of formation

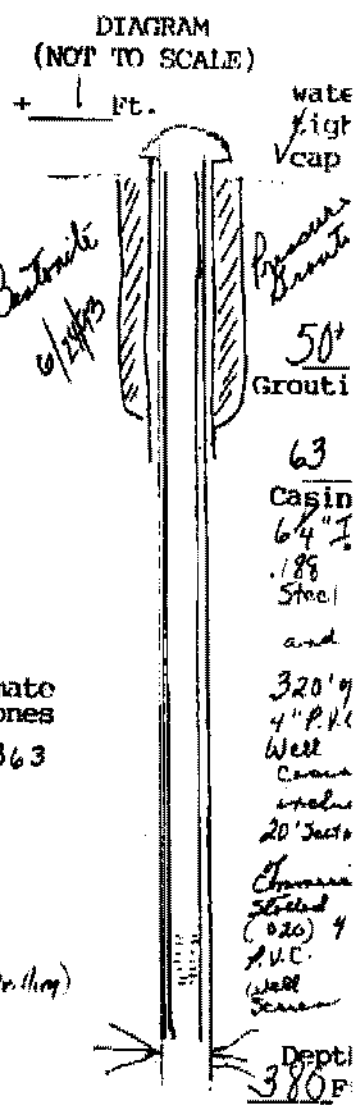

Approximate
 Water Zones
 362 to 363

(Discounted 80' of Drilling)

(User additional Sheets if necessary)

I certify that the information contained here is true and that this well was installed and constructed in accordance with the permit and that the well complies with all applicable state and local regulations, ordinances and laws.

Name: JOHN L. DANIELSON, JR., INC.
 Address: 4616 HOOD DRIVE
FREDERICKSBURG, VIRGINIA 22408
 Phone: (703) 898-6025 / 898-9355

Driller/Signer: [Signature]
 Date: 6/24/93 Representing JOHN L. DANIELSON, JR., INC.

Virginia Contractors License Number CLASS A 2701 014081A H/H WNC