

**Commonwealth of Virginia
Uniform Water Well Completion Report**

Owner: Marie & Stan Beck
 Address: 74 C.L. Walker Blvd, Fredericksburg, Va 22408
 Phone: 891-5081
 Location: 651 off 616

Permit issued to
Richard Beck
290 Kellogg Mill Rd
Fredricksburg 22406
752-2280

Tax Map ID: 36-51
 VDH Permit: WS-93-172
 VWCB Permit: _____
 VWCB ID: _____
 County: Stafford

8/10/93 Robert Sneyden
8/11/93 Gary Switzer

Well Classification IIIA _____ IIIB IIIC _____ IV _____
 * Well Data *

General Information

Drilling Method: Air Rotary
 Depth to Bedrock: 10'
 Static Water Level: 60'
 Well Disinfected (Y or N): _____

Date Completed: 12/6/93
 Yield: 11 (GPM)
 Stabilized Water Level: 2.98'
 Disinfectant Used: _____

Total Depth of Well: 240
 Length of Test: Approx 1 Hr
 Natural Flow (Rate): _____
 Amount Used: _____

Casing

From: 1' To: 85'
 Size: 6 1/2" Material: P.V.C.
 Weight/Schedule: SDR 27

From: _____ To: _____
 Size: _____ Material: _____
 Weight/Schedule: _____

From: _____ To: _____
 Size: _____ Material: _____
 Weight/Schedule: _____

Gravel Pack

From: _____ To: _____
 Hole size: 10 1/8" from 0 to 60 ft.

From: _____ To: _____
 Hole size: 7 7/8" from 60 to 84 ft.

From: _____ To: _____
 Hole size: 6 1/8" from 84 to 240 ft.

Grout: From: 0 To: 50+
 Bore Hole Size: 10 1/8"
 Type: Bentonite
 Method: Pressure Grouting

From: _____ To: _____
 Bore Hole Size: _____
 Type: _____
 Method: _____

From: _____ To: _____
 Bore Hole Size: _____
 Type: _____
 Method: _____

Water Zones or Screened Intervals

From: 230 To: 231
 Mesh Size: _____ Diam: _____
 From: _____ To: _____
 Mesh Size: _____ Diam: _____

From: _____ To: _____
 Mesh Size: _____ Diam: _____

*** Use Data ***

Private Well: Domestic Agricultural _____ Industrial _____ Monitoring _____
 Public Well: Community _____ Non Community _____

*** Abandonment Information ***

Bored or Dug Wells

Casing Removed, Y or N?: _____
 If Y, Depth to which casing was removed: _____
 Depth and Type of Fill: _____
 Source of Fill: _____
 Bentonite Plugs: From _____ to _____ From _____ to _____

Wells other than Bored Wells

Casing removed, Y or N?: _____
 Depth to which casing was removed: _____
 Applicable, depth(s), and type of gravel/sand fill: _____
 Source of gravel or sand: _____
 Cement: From _____ to _____ From _____ to _____


Method of permanently marking location: _____
 Installed watertight top
 Suggest setting pump @ approx 220 ft.

Lane & Thore Duck

Stafford 651
Post Creek Lane

* Drillers Log *

Depth	Description of Formation or Sediment	Remarks
0	10	Red Clay
10	30	Micaceous formation / Red
30	60	Micaceous formation / Brown
60	84	Soft Brown Shale
84	240	Blue Granite

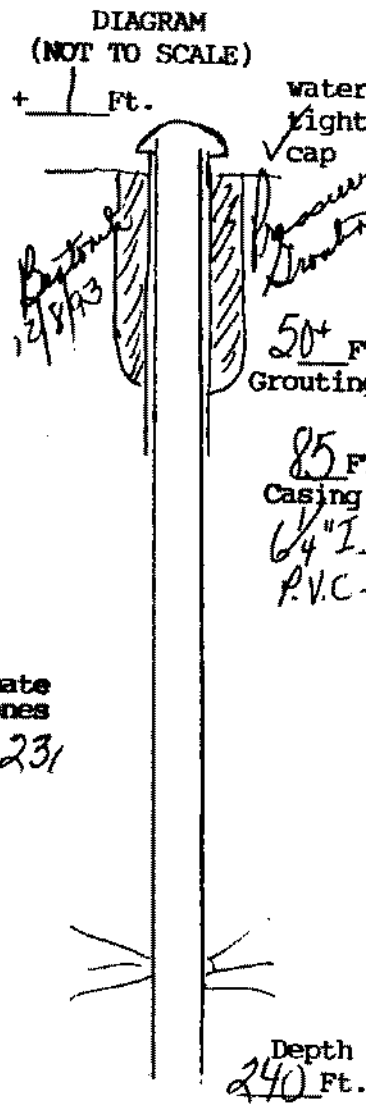

Approximate Water Zones
230 to 231

(User additional Sheets if necessary)

I certify that the information contained here is true and that this well was installed and constructed in accordance with the permit and further that the well complies with all applicable state and local regulations, ordinances and laws.

Name JOHN L. DANIELSON, JR., INC.
 Address 4616 HOOD DRIVE
FREDERICKSBURG, VIRGINIA 22408
 Phone (703) 898-6025 / 898-9355

Drillers Signature John L. Danielson, Pres.
 Date 12/8/93 Representing JOHN L. DANIELSON, JR., INC.

Virginia Contractors License Number CLASS A 2701 014084A H/H WWC