

W.C. Ward
1007 Julian Drive
Dreherburg, Va 22405
373-4971

Commonwealth of Virginia
Uniform Water Well Completion Report

Owner Daniel C. Wildman
Address 34 Snow Bird Lane
Stafford, Va. 22554
Phone 652-5675
Location off #653 - Wall's Chapel Rd. / End of State Maint.

Tax Map ID 37-13B
VDH Permit 189-89-27
VWCB Permit _____
VWCB ID _____
County Stafford
2-7-89 Aristmanadia

Well Classification IIIA _____ IIIB IIIC _____ IV ($\frac{1}{2}$ mile)
* Well Data *

General Information

Drilling Method 200 Date Completed 11/3/92 Total Depth of Well 200
Depth to Bedrock 29' Yield 12 (GPM) Length of Test 1 Hr
Static Water Level 40' Stabilized Water Level 160 Natural Flow (Rate) _____
Well Disinfected (Y or N) _____ Disinfectant Used _____ Amount Used _____

Casing

From +1 To 55 From _____ To _____ From _____ To _____
Size 6 1/4" Material PVC Size _____ Material _____ Size _____ Material _____
Weight/Schedule SDR27 Weight/Schedule _____ Weight/Schedule _____

Gravel Pack

From _____ To _____ From _____ To _____ From _____ To _____
Hole size 10" from 0 to 55 ft. 6 1/8" from 55 to 200 ft. _____ " from _____ to _____ ft.

Grout

From 0 To 50+ ft From _____ To _____ From _____ To _____
Bore Hole Size 10" Bore Hole Size _____ Bore Hole Size _____
Type Bentonite 11/92 Type _____ Type _____
Method Pressure Grouting Method _____ Method _____

Water Zones or Screened Intervals

From 140 To 141 From _____ To _____ From _____ To _____
Mesh Size _____ Diam _____ Mesh Size _____ Diam _____ Mesh Size _____ Diam _____
From 180 To 181 From _____ To _____ From _____ To _____
Mesh Size _____ Diam _____ Mesh Size _____ Diam _____ Mesh Size _____ Diam _____

* Use Data *

Private Well: Domestic Agricultural _____ Industrial _____ Monitoring _____
Public Well: Community _____ Non Community _____

* Abandonment Information *

11/10/92
3/4 H.P. Goulds Submersible
10 GPM SN# AA 572LE
WX 250 Tank

Bored or Dug Wells

Casing Removed, Y or N? _____
If Y, Depth to which casing was removed: _____
Depth and Type of Fill: _____
Source of Fill _____
Bentonite Plugs: From _____ to _____ From _____ to _____

Wells other than Bored Wells

Casing removed, Y or N? _____
Depth to which casing was removed: _____
Applicable, depth(s), and type of gravel/sand fill: _____
Source of gravel or sand: _____
Cement: From _____ to _____ From _____ to _____

Method of permanently marking location: _____
 Installed watertight top
Suggest setting pump @ approx. 160 ft.

Gary Ward

Daniel Wildman

Stafford

Approx 1/2 Mile of #653
(Hull's Chapel Rd) • Drillers Log •

Depth


Description of Formation or Sediment

Remarks

0	10	Red Clay
10	29	Brown Clay
29	200	Light & Dark Grey Rock

DIAGRAM
(NOT TO SCALE)

Ft.

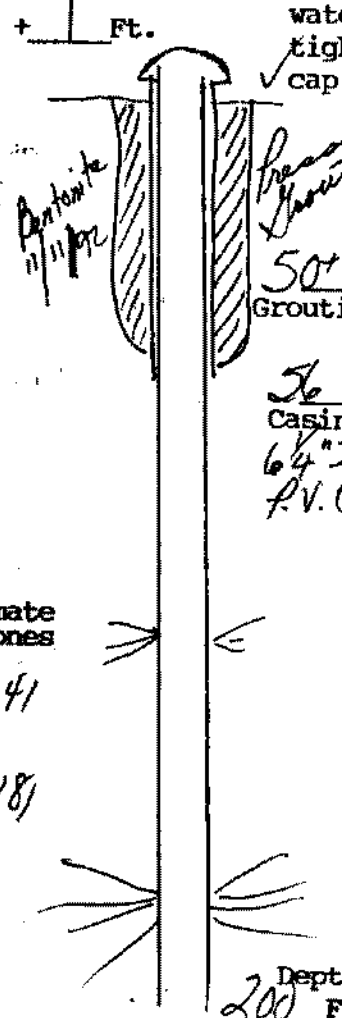

Approximate
Water Zones

140 to 141

and

180 to 181

(User additional Sheets if necessary)

I certify that the information contained here is true and that this well was installed and constructed in accordance with the permit and further that the well complies with all applicable state and local regulations, ordinances and laws.

Name JOHN L. DANIELSON, JR., INC.

Address 4616 HOOD DRIVE

FREDERICKSBURG, VIRGINIA 22408

Phone (703) 898-6025 / 898-9355

Drillers Signature

John L. Danielson

Date 11/11/92 Representing JOHN L. DANIELSON, JR., INC.

Virginia Contractors License Number _____