

**Commonwealth of Virginia
Uniform Water Well Completion Report**

Owner Dan Jullo Permit issued to Jeffrey Kirby Reid Tax Map ID 37A-10
 Address 145 Lake Forest Drive Beaufort Co. NC VDH Permit W-94294
 Phone 659-2926 F. O. 659-2934 221-5887 VWCB Permit _____
 Location Abel Lake Forest #10 (Lake Forest Drive) Fredericksburg Va. 22406 VWCB ID _____
 County STAFFORD
 Well Classification IIIA IIIBV IIIC IV
3/4 M. L. SOUTH #6517 Abel Lake Forest * Well Data * 3/16/94 Daniel J. Jumbo
3/17/94 J.D. Thompson
SFF

General Information

Drilling Method air Rotary Date Completed 10/20/95 Total Depth of Well 500'
 Depth to Bedrock 90 Yield 1 (GPM) Length of Test approx 1 Hr.
 Static Water Level 60 Stabilized Water Level approx 460' Natural Flow (Rate) _____
 Well Disinfected (Y or N) _____ Disinfectant Used _____ Amount Used _____

Casing

From t1 To 110 From 100 To 460 From 480 To 500
 Size 6 3/4 Material P.V.C. Size 4" Material P.V.C. Size 4" Material P.V.C.
 Weight/Schedule SDR 27 Weight/Schedule Sch 40 Weight/Schedule Sch 40

Gravel Pack

From _____ To _____ From _____ To _____ From _____ To _____

Hole size

10" from 0 to 60 ft. 7 1/8" from 60 to 110 ft. 6 1/2" from 110 to 500 ft.

Grout

From 0 To 50' From _____ To _____ From _____ To _____
 Bore Hole Size 10" 10" Bore Hole Size _____ Bore Hole Size _____
 Type Bentonite 193/95 Type _____ Type _____
 Method Pressure Grouting Method _____ Method _____

Water Zones or Screened Intervals

From 460 To 480 From approx water zones 150 To 151 From _____ To _____
 Mesh Size .020 Diam 4" (P.V.C.) Mesh Size _____ Diam _____ Mesh Size _____ Diam _____
 From _____ To _____ From 420 To 421 From _____ To _____
 Mesh Size _____ Diam _____ Mesh Size _____ Diam _____ Mesh Size _____ Diam _____

*** Use Data ***

Private Well: Domestic Agricultural _____ Industrial _____ Monitoring _____
 Public Well: Community _____ Non Community _____

*** Abandonment Information ***

Bored or Dug Wells

Casing Removed, Y or N?: _____
 If Y, Depth to which casing was removed: _____
 Depth and Type of Fill: _____
 Source of Fill _____
 Bentonite Plugs: From _____ to _____ From _____ to _____

Wells other than Bored Wells

Casing removed, Y or N? _____
 Depth to which casing was removed: _____
 Applicable, depth(s), and type of gravel/sand fill: _____
 Source of gravel or sand: _____
 Cement: From _____ to _____ From _____ to _____

Method of permanently marking location:

Installed watertight top
 - Suggest setting pump @ approx. 480 ft.
 - you will encounter 4" casing @ approx 100'
 - Suggest keeping centralizers & torque arrestors out of 4" casing.


15' UNCL. 10/23/95

Van Iullak
Abel Lake Forest #10
Stafford
Lake Forest Drive

* Drillers Log *

Depth	Description of Formation or Sediment	Remarks
0	10	Red Clay
10	40	Micaceous formation / Red
40	70	Micaceous formation / Brown
70	110	Brown Shale
110	500	Blue Shale

Set 4" P.V.C. Well Casing & Screen due to the softness of the formation

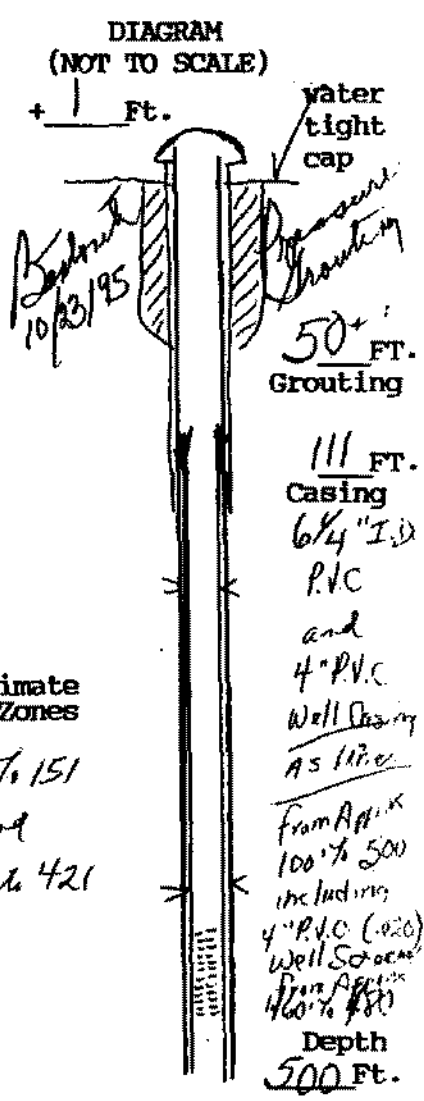

Approximate Water Zones
150 to 151
and
420 to 421

(User additional Sheets if necessary)

I certify that the information contained here is true and that this well was installed and constructed in accordance with the permit and further that the well complies with all applicable state and local regulations, ordinances and laws.

Name JOHN L. DANIELSON, JR., INC.
Address 4616 HOOD DRIVE
FREDERICKSBURG, VIRGINIA 22408
Phone (703) 898-6025 / 898-9355

Drillers Signature John L. Danielson, Jr.
Date 10/23/95 Representing JOHN L. DANIELSON, JR., INC.

Virginia Contractors License Number CLASS A 2701 014084A II/H WMC