

**Commonwealth of Virginia
Uniform Water Well Completion Report**

Owner Ronnie Parks
 Address 362 Esking Hill Road
Stafford, Va 22556
 Phone 659-44-3939
 Location off #28 - Adj to Camp #21

Tax Map ID 38-130
 VDH Permit 189-88-356
 VWCB Permit _____
 VWCB ID _____
 County Stafford
7/13/88 Karl Rudolph

Well Classification IIIA _____ IIIB IIIC _____ IV _____
 * Well Data *

General information

Drilling Method Air Rotary Date Completed 12/23/92 Total Depth of Well 120
 Depth to Bedrock _____ Yield 30 (GPM) Length of Test 1 Hr.
 Static Water Level 20 Stabilized Water Level 60 Natural Flow (Rate) _____
 Well Disinfected (Y or N) _____ Disinfectant Used _____ Amount Used _____

Casing

From <u>+1</u> To <u>60</u>	From <u>60</u> To <u>80</u>	From <u>95</u> To <u>100</u>
Size <u>6 1/4</u> Material <u>P.V.C.</u>	Size <u>6 1/4</u> Material <u>P.V.C.</u>	Size <u>4</u> Material <u>P.V.C.</u>
Weight/Schedule <u>SDR 27</u>	Weight/Schedule <u>SDR 21</u>	Weight/Schedule <u>Schedule 40</u>

Gravel Pack

From _____ To _____	From _____ To _____	From _____ To _____
Hole size <u>10" from 0 to 50ft.</u>	<u>7 1/8" from 50 to 100ft.</u>	<u>6" from 100 to 120ft.</u>

Grout

From <u>0</u> To <u>50+</u>	From _____ To _____	From _____ To _____
Bore Hole Size <u>10" 12/9/92</u>	Bore Hole Size _____	Bore Hole Size _____
Type <u>Bentonite</u>	Type _____	Type _____
Method <u>Pressure Grouting</u>	Method _____	Method _____

Water Zones or Screened Intervals

From <u>100</u> To <u>120</u>	<u>approx water zone</u> From <u>102</u> To <u>118</u>	From _____ To _____
Mesh Size <u>20</u> Diam <u>4" (P.V.C.)</u>	Mesh Size _____ Diam _____	Mesh Size _____ Diam _____
From _____ To _____	From _____ To _____	From _____ To _____
Mesh Size _____ Diam _____	Mesh Size _____ Diam _____	Mesh Size _____ Diam _____

*** Use Data ***

Private Well: Domestic Agricultural _____ Industrial _____ Monitoring _____
 Public Well: Community _____ Non Community _____

*** Abandonment Information ***

Bored or Dug Wells

Casing Removed, Y or N? _____
 If Y, Depth to which casing was removed: _____
 Depth and Type of Fill: _____
 Source of Fill _____
 Bentonite Plugs: From _____ to _____ From _____ to _____

Wells other than Bored Wells

Casing removed, Y or N? _____
 Depth to which casing was removed: _____
 Applicable, depth(s), and type of gravel/sand fill: _____
 Source of gravel or sand: _____
 Cement: From _____ to _____ From _____ to _____

Method of permanently marking location:

Installed watertight top
 Suggest setting pump @ approx. 95 ft.


Rossie Kanks

Sheppard 628
Adj to Camp 2

• Drillers Log •

Depth	Description of Formation or Sediment	Remarks
0	2	Fill (Top Soil)
2	20	Brown Clay
20	90	Red Sandy Gravel ^{1/2} clay
90	102	Brown Clay
102	118	White Sand
118	120	Gray Clay

DIAGRAM
(NOT TO SCALE)

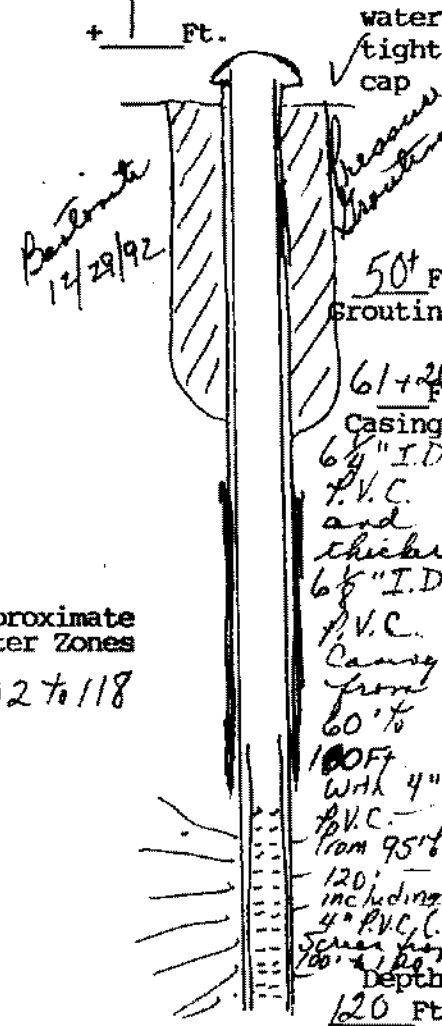

(User additional Sheets if necessary)

I certify that the information contained here is true and that this well was installed and constructed in accordance with the permit and further that the well complies with all applicable state and local regulations, ordinances and laws.

Name JOHN L. DANIELSON, JR., INC.
Address 4616 HOOD DRIVE
FREDERICKSBURG, VIRGINIA 22408
Phone (703) 898-6025 / 898-9355

Drillers Signature [Signature]
Date 12/29/92 Representing JOHN L. DANIELSON, JR., INC.

Virginia Contractors License Number _____