


COMMONWEALTH OF VIRGINIA
WATER WELL COMPLETION REPORT
(Certification of Completion/County Permit)

• BWCM No. _____

39-17A-2

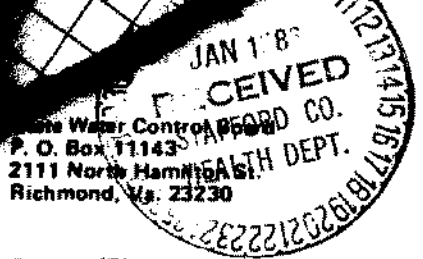

County/City Stafford County/City Stamp _____

SWCB Permit _____
County Permit _____
Certification of inspecting official: This well does _____ does not _____ meet code/low requirements. S. _____ Date _____
<i>For Office Use</i>

• Virginia Plane Coordinates	N _____
	E _____
Latitude & Longitude	N _____
	W _____
• Topo. Map No. _____	
• Elevation _____	ft.
• Formation _____	
• Lithology _____	
• River Basin _____	
• Province _____	
• Type Logs _____	
• Cuttings _____	
• Water Analysis _____	
• Aquifer Test _____	

• Owner Otto Comdest
 • Well Designation or Number _____
 Address P.O. Box 640
Stafford, VA, 22554
 Phone 659-7117

• Drilling Contractor Van's Construction Co., Inc.
 Address P.O. Box 3306 College Station
Fredericksburg, VA. 22402
 Phone 373-7502

Tax Map I.D. No. _____
Subdivision _____
Section _____
Block _____
Lot _____
Class Well I _____, IIA _____
IIIB _____, IIIA _____, IIIB <u>X</u>
IIIC _____, IIID _____, IIIE _____

WELL LOCATION: _____ (feet/miles _____ direction) of _____
 and _____ (feet/miles _____ direction) of _____
 (If possible please include map showing location marked)

Date started 3-12-83 • Date completed 3-12-83 Type rig Boring

1. WELL DATA: New X Reworked _____ Deepened _____

• Total depth 70 ft.

• Depth to bedrock - ft.

• Hole size (Also include reamed zones)

- 30 inches from 0 to 20 ft.
- 28 inches from 20 to 70 ft.
- _____ inches from _____ to _____ ft.

• Casings size (I.D.) and material

- 24 inches from 0 to 70 ft.
Material concrete
Wt. per foot _____ or wall thickness _____ in.
- _____ inches from _____ to _____ ft.
Material _____
Wt. per foot _____ or wall thickness _____ in.
- _____ inches from _____ to _____ ft.
Material _____
Wt. per foot _____ or wall thickness _____ in.

• Screen size and mesh for each zone (where applicable)

- _____ inches from _____ to _____ ft.
- Mesh size _____ Type _____
- _____ inches from _____ to _____ ft.
- Mesh size _____ Type _____
- _____ inches from _____ to _____ ft.
- Mesh size _____ Type _____
- _____ inches from _____ to _____ ft.
- Mesh size _____ Type _____

• Gravel pack

- From _____ to _____ ft.
- From _____ to _____ ft.

• Grout

- From _____ to _____ ft., Type _____
- From _____ to _____ ft., Type _____

2. WATER DATA • Water temperature _____ OF

- Static water level (unpumped level) measured _____ ft.
- Stabilized measured pumping water level _____ ft.
- Stabilized yield 5 gpm after est. bail method hours
- Natural Flow: Yes _____ No X flow rate _____ g pm
- Comment on quality _____

3. WATER ZONES: From _____ To _____

From _____ To _____ From _____ To _____

From _____ To _____ From _____ To _____

4. USE DATA:

Type of use: Drinking X Livestock Watering _____

Irrigation _____ Food processing _____ Household X

Manufacturing _____ Fire safety _____ Cleaning _____

Recreation _____ Aesthetic _____ Cooling or heating _____

Injection _____ Other _____

• Type of facility: Domestic X Public water supply _____

Public institution _____ Farm _____ Industry _____

Commercial _____ Other _____

5. PUMP DATA: Type _____ • Rated H.P. _____

• Intake depth _____ • Capacity _____ at _____ head

6. WELLHEAD: Type well seal _____

Pressure tank _____ gal., Loc. _____

Sample tap _____ Measurement port _____

Well vent _____ Pressure relief valve _____

Gate valve _____ Check valve (when required) _____

Electrical disconnect switch on power supply _____

7. DISINFECTION: Well disinfected _____ yes _____ no _____

Date _____ Disinfectant used _____

Amount _____ Hours used _____

8. ABANDONMENT (where applicable) • yes _____ no _____

Casing pulled yes _____ no _____ not applicable _____

Plugging grout From _____ to _____ material _____

Owner Otto Comdest

BWCM No. _____

9. State law requires submitting to the Virginia State Water Control Board information about groundwater and wells for every well made in the State intended for water, or any other non-exempt well. This information must be submitted whether the well is completed, on standby, or abandoned. Information required includes: an accurately and completely prepared water well completion report, full data from any aquifer pumping tests, drill cuttings taken at ten foot intervals (unless exemption is secured), the results of any chemical analyses, and copies of any geophysical logs. Quarterly pumpage and use reports are required from owners of public supply and industrial wells. County or State permits to drill may be required in some parts of the state. Some counties require submission of a water well completion report. The Virginia State Health Department requires a water well completion report for public supply wells.

10. DRILLERS LOG (use additional Sheets if necessary)

10. DRILLERS LOG (use additional Sheets if necessary)			11.	12. DIAGRAM OF WELL CONSTRUCTION (with dimensions)
DEPTH (feet)		TYPE OF ROCK OR SOIL	REMARKS	Drilling Time (Min.)
From	To	(color, material, fossils, hardness, etc.)	(water, caving, cavities, broken, core, shot, (etc.))	
0	70	clay, sand, mica		

13. Well lot dedicated? _____ Size _____ ft. X _____ ft. Well house? _____
Distance to nearest pollutant source _____ ft., Type _____
Distance to nearest property line _____ ft., Building _____ ft.

State Water Control Board Regional Offices

Valley Reg. Off.
116 North Main Street
P. O. Box 268
Bridgewater, Va. 22812
703-828-2595

Piedmont Reg. Off.
4010 West Broad Street
P. O. Box 6616
Richmond, Va. 23230
804-257-1006

Southwest Reg. Off.
408 East Main Street
P. O. Box 476
Abingdon, Va. 24210
703-628-5183

Tidewater Reg. Off.
287 Pembroke Office Park
Suite 310 Pembroke No. 2
Va. Beach, Va. 23462
804-499-8742

West Central Reg. Off.
Executive Park
5312 Peters Creek Road
Roanoke, Va. 24019
703-882-7432

Northern Virginia Reg. Off.
5515 Charokee Avenue
Suite 404
Alexandria, Va. 22312
703-750-9111

14. WATER SERVICE PIPE: Checked under _____ p. s. i. for _____ minutes. Pipe size _____ inches, Material _____
Installer _____
Date _____

15. I certify that the information contained herein is true and correct and that this well and/or system has been installed and constructed in accordance with the requirements for well construction as specified in compliance with appropriate county or independent city ordinances and the laws and rules of the Commonwealth of Virginia.

Signature Shabbar Hussain, Inc. (Seal), Date 12-30-85
(Well driller or authorized person) License No. _____