

Sealed by \_\_\_\_\_  
Unsealed by \_\_\_\_\_  
Date \_\_\_\_\_

W. Stealy

Steel Enterprises  
207 Brook Road  
Fredricksburg, VA 22405

Commonwealth of Virginia  
Uniform Water Well Completion Report

Owner Kirk & Lisa Byler  
Address 1458 Brook Road  
Stafford, VA 22554  
Phone 11659-4379  
Location Cheroke Hill Road

Tax Map ID 39-31  
VDH Permit SWP-01-192  
VWCB Permit \_\_\_\_\_  
VWCB ID \_\_\_\_\_  
County Stafford  
3/14/01 John Handouin  
Jason Wagner  
MK

Well Classification IIIA \_\_\_\_\_ IIIB  IIIC \_\_\_\_\_ IV \_\_\_\_\_  
\* Well Data \*

General Information  
Drilling Method Hand Rotary  
Depth to Bedrock \_\_\_\_\_  
Static Water Level \_\_\_\_\_  
Well Disinfected (Y or N): \_\_\_\_\_

Date Completed 10/23/01  
Yield 25 (GPM)  
Stabilized Water Level 240'  
Disinfectant Used \_\_\_\_\_

Total Depth of Well 325  
Length of Test approx 1 Hr.  
Natural Flow (Rate) \_\_\_\_\_  
Amount Used \_\_\_\_\_

Casing  
From +1 To 265  
Size 4 1/2" Material PVC  
Weight/Schedule SDR 17

From 285 To 325  
Size 4 1/2" Material PVC  
Weight/Schedule SDR 17

From \_\_\_\_\_ To \_\_\_\_\_  
Size \_\_\_\_\_ Material \_\_\_\_\_  
Weight/Schedule \_\_\_\_\_

Gravel Pack  
From 50 To 325  
Hole size 8 1/4" From 0 to 325 ft.  
Grout  
From 0 To 50' 10"  
Bore Hole Size 8 7/8" FE/0  
Type Bentonite  
Method Pressure Grouting

From \_\_\_\_\_ To \_\_\_\_\_  
" from \_\_\_\_\_ to \_\_\_\_\_ ft.  
From \_\_\_\_\_ To \_\_\_\_\_  
Bore Hole Size \_\_\_\_\_  
Type \_\_\_\_\_  
Method \_\_\_\_\_

From \_\_\_\_\_ To \_\_\_\_\_  
" from \_\_\_\_\_ to \_\_\_\_\_ ft.  
From \_\_\_\_\_ To \_\_\_\_\_  
Bore Hole Size \_\_\_\_\_  
Type \_\_\_\_\_  
Method \_\_\_\_\_

Water Zones or Screened Intervals  
From 265 To 285  
Mesh Size 0.20 Diam 4 1/2" (PVC)  
From \_\_\_\_\_ To \_\_\_\_\_  
Mesh Size \_\_\_\_\_ Diam \_\_\_\_\_

From 265 To 280  
Mesh Size \_\_\_\_\_ Diam \_\_\_\_\_  
From \_\_\_\_\_ To \_\_\_\_\_  
Mesh Size \_\_\_\_\_ Diam \_\_\_\_\_

From \_\_\_\_\_ To \_\_\_\_\_  
Mesh Size \_\_\_\_\_ Diam \_\_\_\_\_  
From \_\_\_\_\_ To \_\_\_\_\_  
Mesh Size \_\_\_\_\_ Diam \_\_\_\_\_

\* Use Data \*

Private Well: Domestic  Agricultural \_\_\_\_\_ Industrial \_\_\_\_\_ Monitoring \_\_\_\_\_  
Public Well: Community \_\_\_\_\_ Non Community \_\_\_\_\_

\* Abandonment Information \*

Bored or Dug Wells  
Casing Removed, Y or N?: \_\_\_\_\_  
If Y, Depth to which casing was removed: \_\_\_\_\_  
Depth and Type of Fill: \_\_\_\_\_  
Source of Fill \_\_\_\_\_  
Bentonite Plugs: From \_\_\_\_\_ to \_\_\_\_\_ From \_\_\_\_\_ to \_\_\_\_\_


Wells other than Bored Wells  
Casing removed, Y or N? \_\_\_\_\_  
Depth to which casing was removed: \_\_\_\_\_  
Applicable, depth(s), and type of gravel/sand fill: \_\_\_\_\_  
Source of gravel or sand: \_\_\_\_\_  
Cement: From \_\_\_\_\_ to \_\_\_\_\_ From \_\_\_\_\_ to \_\_\_\_\_

Method of permanently marking location: \_\_\_\_\_  
 Installed watertight top  
Suggest setting pump @ approx 260 ft.

Bert Steele  
 Steele Enterprises  
 Rick & Lisa Butler  
 Casper Hill Road  
 Stafford

\* Drillers Log \*

Depth	Description of Formation or Sediment	Remarks
0 10'	Red Clay	(4 1/2")
10 45	Black Sand	
45 60	Grey clay	
60 75	Brown Clay	
75 145	Grey Sandy Clay	
145 170	Grey Clay	
170 240	Sandy Grey clay	
240 260	Grey clay	
260 265	Sandy Grey Clay	
265 280	Sand - water zone	
280 300	Sandy Grey clay	
300 305	Sand	
305 325	Sandy Grey clay	

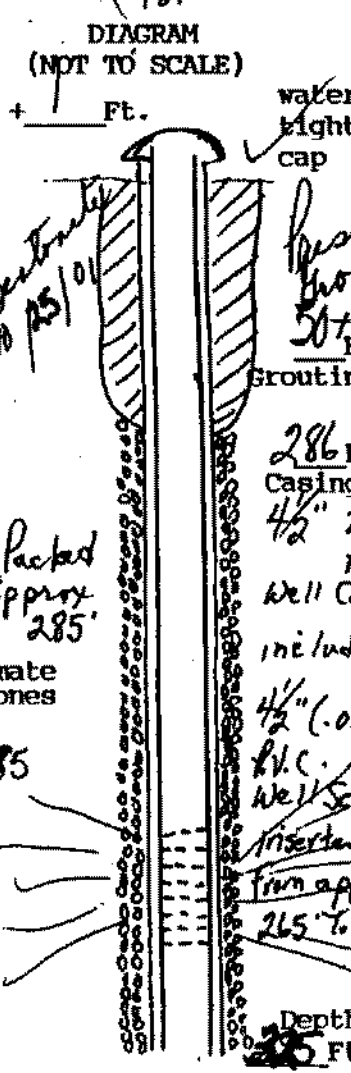

(Use additional Sheets if necessary)

I certify that the information contained here is true and that this well was installed and constructed in accordance with the permit and further that the well complies with all applicable state and local regulations, ordinances and laws.

Name JOHN L. DANIELSON, JR., INC.  
 Address 1616 HOOD DRIVE  
FREDERICKSBURG, VIRGINIA 22408  
 Phone (540) 898-6025 / 898-9355

Drillers Signature [Signature]  
 Date 10/26/01 Representing JOHN L. DANIELSON, JR., INC.

Virginia Contractors Licence Number CLASS A 2701 014084A II/II WWC