

Commonwealth of Virginia  
 Uniform Water Well Completion Report

Address: Rodney Thomas  
11657 Church Rd  
Salmonville, Va 22406  
 Phone: 720-5882  
 Location: Brooke  
 Well Classification: IIIA  IIIB  IIIC  IV   
 \* Well Data \*

Tax Map ID: 39-3-1  
 VDH Permit: SWP-96-11  
 VWCB Permit: \_\_\_\_\_  
 VWCB ID: \_\_\_\_\_  
 County: STAFFORD  
1/25/96 Ashlan B Wright  
SFF

General Information  
 Drilling Method: Air Rotary  
 Depth to Bedrock: \_\_\_\_\_  
 Static Water Level: 40'  
 Well Disinfected (Y or N): \_\_\_\_\_

Date Completed: 4/25/96  
 Yield: 30 (GPM)  
 Stabilized Water Level: 100'  
 Disinfectant Used: \_\_\_\_\_

Total Depth of Well: 160'  
 Length of Test: approx 1 Hr.  
 Natural Flow (Rate): \_\_\_\_\_  
 Amount Used: \_\_\_\_\_

Casing  
 From 11 To 55  
 Size 6 1/4 Material P.V.C.  
 Weight/Schedule SDR 27

From 50 To 130  
 Size 4" Material P.V.C.  
 Weight/Schedule SCL 40

From 150 To 160  
 Size 4" Material P.V.C.  
 Weight/Schedule Sch 40

Gravel Pack  
 From \_\_\_\_\_ To \_\_\_\_\_  
 Hole size: 10" From 0 to 50 ft.  
 Grout: \_\_\_\_\_  
 From 0 To 50'  
 Bore Hole Size: 10"  
 Type: Bentonite  
 Method: Pressure Grouting

From \_\_\_\_\_ To \_\_\_\_\_  
 Hole size: 7 1/8" from 50 to 55 ft.  
 Grout: \_\_\_\_\_  
 From \_\_\_\_\_ To \_\_\_\_\_  
 Bore Hole Size: \_\_\_\_\_  
 Type: \_\_\_\_\_  
 Method: \_\_\_\_\_

From \_\_\_\_\_ To \_\_\_\_\_  
 Hole size: 6 1/8" from 55 to 160 ft.  
 Grout: \_\_\_\_\_  
 From \_\_\_\_\_ To \_\_\_\_\_  
 Bore Hole Size: \_\_\_\_\_  
 Type: \_\_\_\_\_  
 Method: \_\_\_\_\_

Water Zones or Screened Intervals  
 From 130 To 150  
 Mesh Size: 020 Diam 4" (P.V.C.)  
 From \_\_\_\_\_ To \_\_\_\_\_  
 Mesh Size \_\_\_\_\_ Diam \_\_\_\_\_

From \_\_\_\_\_ To \_\_\_\_\_  
 Mesh Size \_\_\_\_\_ Diam \_\_\_\_\_  
\* Use Data \*

Private Well: Domestic  Agricultural \_\_\_\_\_ Industrial \_\_\_\_\_ Monitoring \_\_\_\_\_  
 Public Well: Community \_\_\_\_\_ Non Community \_\_\_\_\_

\* Abandonment Information \*

Bored or Dug Wells  
 Casing Removed, Y or N?: \_\_\_\_\_  
 If Y, Depth to which casing was removed: \_\_\_\_\_  
 Depth and Type of Fill: \_\_\_\_\_  
 Source of Fill: \_\_\_\_\_  
 Bentonite Plugs: From \_\_\_\_\_ to \_\_\_\_\_ From \_\_\_\_\_ to \_\_\_\_\_

Wells other than Bored Wells  
 Casing removed, Y or N? \_\_\_\_\_  
 Depth to which casing was removed: \_\_\_\_\_  
 Applicable, depth(s), and type of gravel/sand fill: \_\_\_\_\_  
 Source of gravel or sand: \_\_\_\_\_  
 Cement: From \_\_\_\_\_ to \_\_\_\_\_ From \_\_\_\_\_ to \_\_\_\_\_


Method of permanently marking location:  
 Installed watertight top  
 Suggest setting pump @ approx. 120 ft.  
You will encounter 4" casing @ approx 50 ft.  
Suggest keeping centralizers & torque arrestors out of 4" casing.  
1547 Brooke Rd / Lot 110 / 01/10/96

*Gary Heppner*  
*Old Town Builders*  
*Brooke Road*  
*Stafford Co. \* Drillers Log \**

NO COLIFORM DETE.  
 TOTAL COLIFORMS DETE.  
 Agency (EPA) sanitary standard  
 Health Department, drinking water  
 TOTAL COLIFORMS AND  
 sanitary standards for possible  
 drinking water contamination.

Depth Description of Formation or Sediment Remarks

0	10	Sandy Red Clay
10	30	yellow sand
30	40	Blue Clay
40	80	sandstone
80	135	Brown Clay
135	150	Gray sand
150	160	Blue Clay

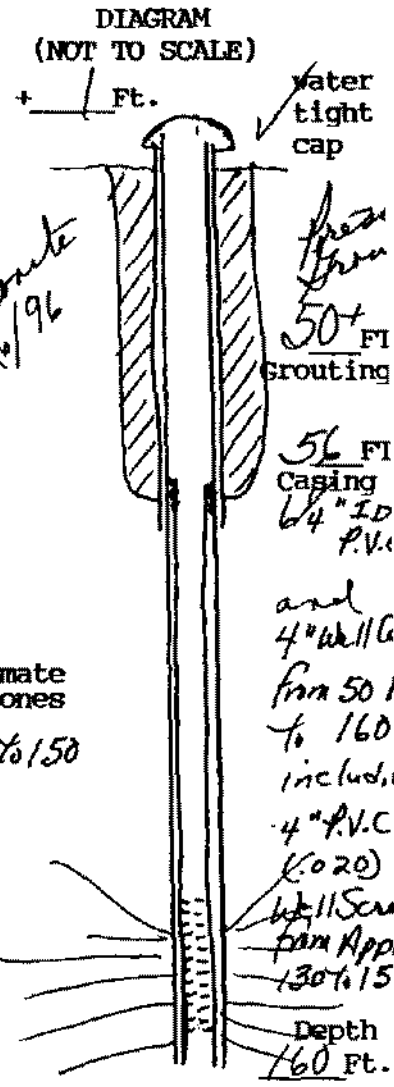

Approximate Water Zones  
 135 to 150



(User additional Sheets if necessary)

I certify that the information contained here is true and that this well was installed and constructed in accordance with the permit and further that the well complies with all applicable state and local regulations, ordinances and laws.

Name JOHN L. DANIELSON, JR., INC.  
 Address 4616 HOOD DRIVE  
FREDERICKSBURG, VIRGINIA 22408  
 Phone 546 (703) 898-6025 / 898-9355  
 Drillers Signature *John L. Danielson, Jr.*  
 Date 4/24/96 Representing JOHN L. DANIELSON, JR., INC.  
 Virginia Contractors License Number CLASS A 2701 014084A II/II WVC