

Commonwealth of Virginia

Uniform Water Well Completion Report

Leesville
Leesville, Bedford
100 W. Liberty Rd.
Leesville, Va 22404
39-4950 657-4950 F-3762-8730 Mob 890-4683

Owner Edward E. Weady, Cotterwood
 Address 237 Overlook Court
Leesville, Va. 22405
 Phone 659-4654
 Location Whiting Family #3
183c
 Well Classification IIIA IIIB IIIC IV
Approx 3/4 M. East of 6304 Anterfield Rd. Well Data *

Tax Map ID 39-89-C
 VDH Permit SWP-96-230
 VWCB Permit _____
 VWCB ID _____
 County Stafford
95% Rural Township
SFF

General Information

Drilling Method Air Rotary
 Depth to Bedrock _____
 Static Water Level 60
 Well Disinfected (Y or N) _____

Date Completed 11/18/96
 Yield 30 (GPM)
 Stabilized Water Level 120
 Disinfectant Used _____

Total Depth of Well 220
 Length of Test approx 1 Hr.
 Natural Flow (Rate) _____
 Amount Used _____

Casing

From +1 To 66
 Size 6 1/4 Material P.V.C.
 Weight/Schedule SDR27

From 60 To 200
 Size 4" Material P.V.C.
 Weight/Schedule Sch. 40

From _____ To _____
 Size _____ Material _____
 Weight/Schedule _____

Gravel Pack

From _____ To _____
 Hole size _____
10" from 2 to 60 ft.
 Grout _____
 From 0 To 50' 11/27/96
 Bore Hole Size 10"
 Type Bentonite
 Method Pressure Grouting

From _____ To _____
 Hole size _____
7 1/8" from 60 to 66 ft.
 Grout _____
 From _____ To _____
 Bore Hole Size _____
 Type _____
 Method _____

From _____ To _____
 Hole size _____
6 1/8" from 66 to 220 ft.
 Grout _____
 From _____ To _____
 Bore Hole Size _____
 Type _____
 Method _____

Water Zones or Screened Intervals

From 200 To 220
 Mesh Size 20 Diam 4" (P.V.C.)
 From _____ To _____
 Mesh Size _____ Diam _____

approx water zone
 From 210 To 218
 Mesh Size _____ Diam _____
 From _____ To _____
 Mesh Size _____ Diam _____

From _____ To _____
 Mesh Size _____ Diam _____
 From _____ To _____
 Mesh Size _____ Diam _____

* Use Data *

Private Well: Domestic Agricultural _____ Industrial _____ Monitoring _____
 Public Well: Community _____ Non Community _____

* Abandonment Information *

Bored or Dug Wells

Casing Removed, Y or N? _____
 If Y, Depth to which casing was removed: _____
 Depth and Type of Fill: _____
 Source of Fill _____
 Bentonite Plugs: From _____ to _____ From _____ to _____

Wells other than Bored Wells

Casing removed, Y or N? _____
 Depth to which casing was removed: _____
 Applicable, depth(s), and type of gravel/sand fill: _____
 Source of gravel or sand: _____
 Cement: From _____ to _____ From _____ to _____


Method of permanently marking location:

Installed watertight top
 Suggest setting pump @ approx. 140 ft.
You will encounter 4" casing @ approx 60 ft.
and three arrestors out of 4" casing.

errand
Old Town Builders
Whiting Family #3
Stafford
 Drillers Log # 630 near Spring Hill & Vestavia

Depth	Description of Formation or Sediment	Remarks
0 10	Sandy Red Clay	
10 40	yellow Sand	
40 60	Sandstone	
60 210	Brown Clay	
210 218	Grey Sand - Water zone	
218 220	Brown Clay	

- DIAGRAM
 (NOT TO SCALE)

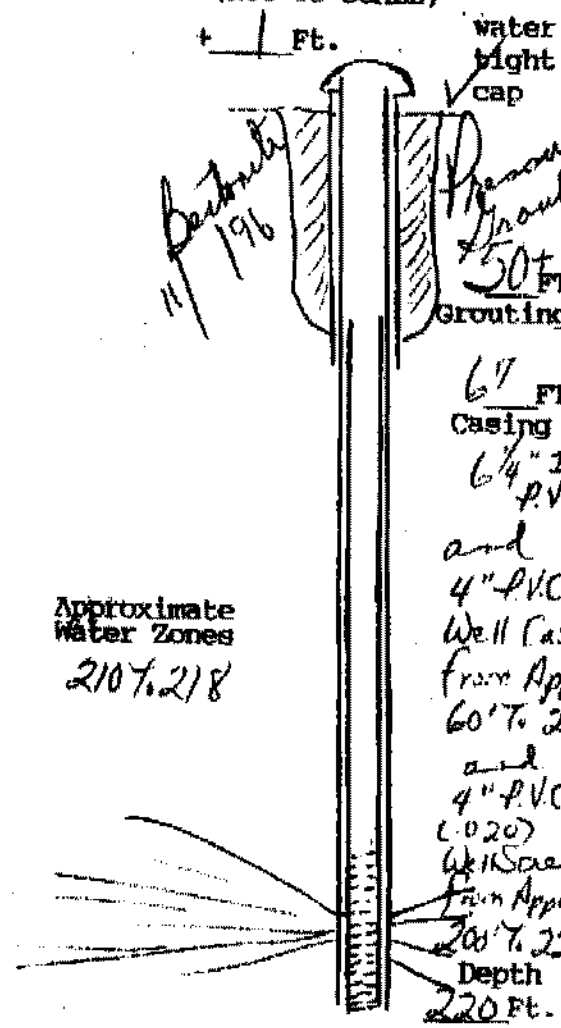

Approximate
 Water Zones
 210 to 218

(Use additional Sheets if necessary)

I certify that the information contained here is true and that this well was installed and constructed in accordance with the permit and further that the well complies with all applicable state and local regulations, ordinances and laws.

Name JOHN L. DANIELSON, JR., INC.
 Address 4616 HOOD DRIVE
FREDERICKSBURG, VIRGINIA 22408
 Phone 540 (703) 890-6025 / 898-9355

Drillers Signature [Signature]
 Date 11/22/96 Representing JOHN L. DANIELSON, JR., INC.

Virginia Contractors Licence Number CLASS A 2701 014084A H/H WWC