

Lockwood
Builders, Inc.
760. Box 170
Lebanon, Va. 22545
752-5380 FAX 752-2963
 Owner William G. Shelton
 Address 15 Old Bridge Road
Stafford Va.

Commonwealth of Virginia
 Uniform Water Well Completion Report

Tax Map ID 39-30 Part
 VDI Permit SWP-96-318
 VWCB Permit _____
 VWCB ID _____
 County Stafford
9/23/96 Daniel Josselyn

Phone _____
 Location #626 / 628 -> R. #626 -> lot on left East Barnhouse
183D Potomac Run Rd.
 Well Classification IIIA IIIB IIIC IV
Approx 3/4 M. North of Inter #628/626 Well Data *

General Information
 Drilling Method Air Rotary
 Depth to Bedrock _____
 Static Water Level 40'
 Well Disinfected (Y or N) _____

Date Completed 1/20/97
 Yield 25' (GPM)
 Stabilized Water Level _____
 Disinfectant Used _____

Total Depth of Well 240'
 Length of Test approx 1 Hr.
 Natural Flow (Rate) _____
 Amount Used _____

Casing
 From +1 To 68
 Size 6 1/4" Material P.V.C.
 Weight/Schedule SDR 27

From 60 To 220
 Size 4" Material P.V.C.
 Weight/Schedule Sch 40

From _____ To _____
 Size _____ Material _____
 Weight/Schedule _____

Gravel Pack
 From _____ To _____

Hole size
10" from 0 to 50ft.
 Grout
 From 0 To 50'
 Bore Hole Size 10"
 Type Bentonite
 Method Pressure Grouting

From _____ To _____
7 1/8" from 50 to 68ft.
 From _____ To _____
 Bore Hole Size _____
 Type _____
 Method _____

From _____ To _____
6 1/2" from 68 to 240ft.
 From _____ To _____
 Bore Hole Size _____
 Type _____
 Method _____

Water Zones or Screened Intervals
 From 220 To 240
 Mesh Size 016 Diam 4" (P.V.C.)
 From _____ To _____
 Mesh Size _____ Diam _____

approx. water zone
 From 220 To 235
 Mesh Size _____ Diam _____
 From _____ To _____
 Mesh Size _____ Diam _____

From _____ To _____
 Mesh Size _____ Diam _____
 From _____ To _____
 Mesh Size _____ Diam _____

* Use Data *

Private Well: Domestic Agricultural _____ Industrial _____ Monitoring _____
 Public Well: Community _____ Non Community _____

* Abandonment Information *

Bored or Dug Wells
 Casing Removed, Y or N? _____
 If Y, Depth to which casing was removed: _____
 Depth and Type of Fill: _____
 Source of Fill _____
 Bentonite Plugs: From _____ to _____ From _____ to _____

Wells other than Bored Wells
 Casing removed, Y or N? _____
 Depth to which casing was removed: _____
 Applicable, depth(s), and type of gravel/sand fill: _____
 Source of gravel or sand: _____
 Cement: From _____ to _____ From _____ to _____

Method of permanently marking location:
 Installed watertight top
 Suggest setting pump @ approx. 180 ft.

You will encounter 4" casing @ approx 60 ft.
Suggest keeping centralizers & torque arrestors out
or 4" beads.


George Lockwood
Open Builders
William G. Shelton

Stafford
 # 626 - Rest Barn House
 off 628 Potomac Run Road

Drillers Log

Depth	Description of Formation or Sediment	Remarks
0 10	Sandy Red Clay	
10 30	Yellow Sand	
30 50	Blue Marl	
50 80	Brown Clay	
80 220	Blue Clay	
220 235	Grey Sand	
235 240	Brown Clay	

DIAGRAM
(NOT TO SCALE)

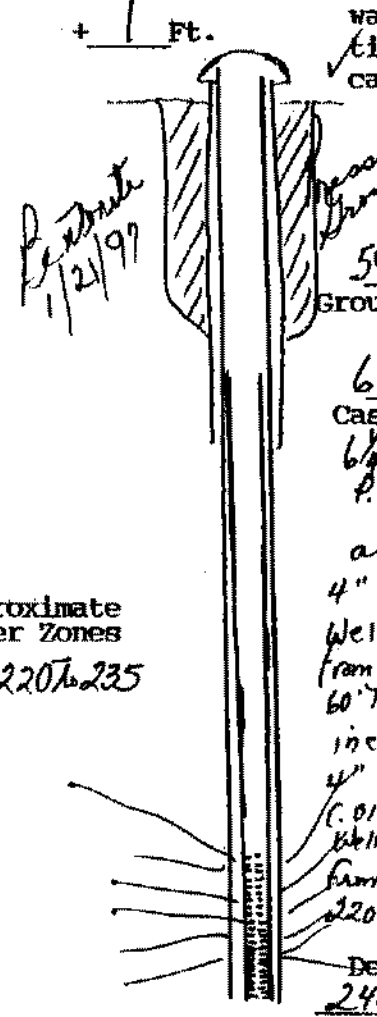

Approximate
Water Zones
220 to 235

(User additional Sheets if necessary)

I certify that the information contained here is true and that this well was installed and constructed in accordance with the permit and further that the well complies with all applicable state and local regulations, ordinances and laws.

Name JOHN L. DANIELSON, JR., INC.
 Address 4616 HOOD DRIVE
FREDERICKSBURG, VIRGINIA 22408
 Phone 540 (703) 898-6025 / 898-9355

Drillers Signature John L. Danielson, Pres.
 Date 1/21/97 Representing JOHN L. DANIELSON, JR., INC.

Virginia Contractors License Number CLASS A 2701 014084A H/H WWC