

Commonwealth of Virginia
 Uniform Water Well Completion Report

Robert Anderson
 490 Mullerough Point Road
 Stafford, Va. 22554
 Phone 659-2533
 Location Fallmaine Sub #3/ Southern View Drive

Tax Map ID 39-29-3
 VDH Permit SWP-97-235
 VWCB Permit _____
 VWCB ID _____
 County Stafford
 7/15/98 Ashton B. Wright
 CRG

Well Classification IIIA _____ IIIB IIIC _____ IV _____
 * Well Data *

General Information
 Drilling Method Mud Rotary
 Depth to Bedrock _____
 Static Water Level approx 120
 Well Disinfected (Y or N) _____

Date Completed 8/21/98
 Yield 30 (GPM)
 Stabilized Water Level 180
 Disinfectant Used _____

Total Depth of Well 325
 Length of Test approx 2 Hrs
 Natural Flow (Rate) _____
 Amount Used _____

Casing
 From 71 To 295
 Size 4 1/2" Material P.V.C.
 Weight/Schedule SDR 17

From 315 To 325
 Size 4 1/2" Material P.V.C.
 Weight/Schedule SDR 17

From _____ To _____
 Size _____ Material _____
 Weight/Schedule _____

Gravel Pack
 From 50 To 325

From _____ To _____

From _____ To _____

Hole size
 7 1/2" from 0 to 325 ft.
 Grout
 From 0 To 50' 8/21/98
 Bore Hole Size 7 1/2"
 Type Cementite
 Method Pressure Grouting

From _____ To _____
 Bore Hole Size _____
 Type _____
 Method _____

From _____ To _____
 Bore Hole Size _____
 Type _____
 Method _____

Water Zones or Screened Intervals
 From 295 To 315
 Mesh Size 20 Diam 4 1/2" (P.V.C.)

approx water zone
 From 290 To 315
 Mesh Size _____ Diam _____

From _____ To _____
 Mesh Size _____ Diam _____

* Use Data *

Private Well: Domestic Agricultural _____ Industrial _____ Monitoring _____
 Public Well: Community _____ Non Community _____

* Abandonment Information *

Bored or Dug Wells
 Casing Removed, Y or N? _____
 If Y, Depth to which casing was removed: _____
 Depth and Type of Fill: _____
 Source of Fill _____
 Bentonite Plugs: From _____ to _____ From _____ to _____


Wells other than Bored Wells
 Casing removed, Y or N? _____
 Depth to which casing was removed: _____
 Applicable, depth(s), and type of gravel/sand fill: _____
 Source of gravel or sand: _____
 Cement: From _____ to _____ From _____ to _____

Method of permanently marking location: _____
 Installed watertight top
 Suggest setting pump @ approx. 200 ft.

Rec Boy
Heartland Homes
Dallinger Sub #3
Stafford
Southern View Drive * Drillers Log *

Depth Description of Formation or Sediment Remarks

0	10	Red Clay
10	50	yellow sand
50	110	Beach sand
110	150	Sand & Gravel
150	190	Grey clay
190	250	Red Clay
250	270	Sandy Grey clay
270	315	Grey sand - water zone
315	325	Grey clay

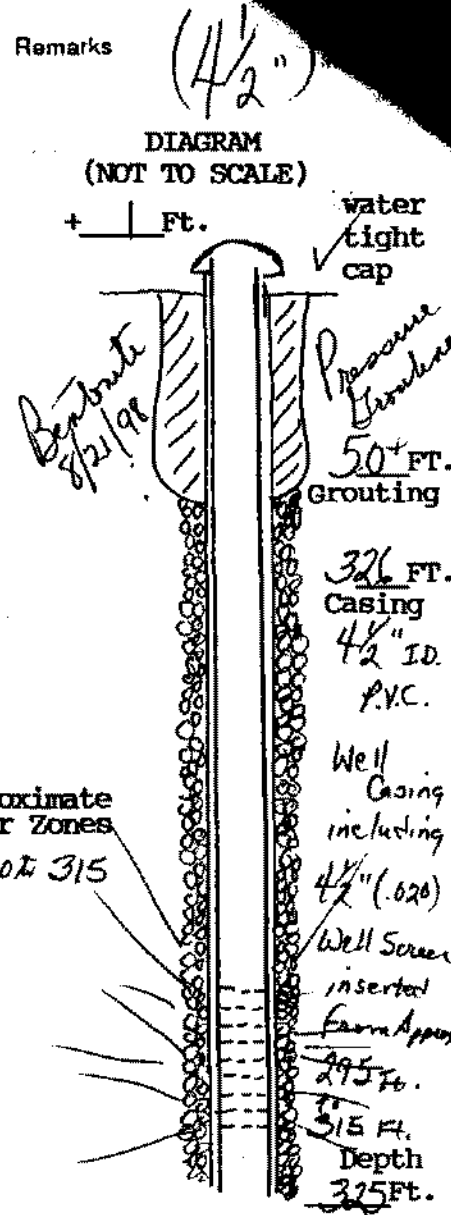

(User additional Sheets if necessary)

I certify that the information contained here is true and that this well was installed and constructed in accordance with the permit and further that the well complies with all applicable state and local regulations, ordinances and laws.

Name JOHN L. DANIELSON, JR., INC.
 Address 4616 HOOD DRIVE
FREDERICKSBURG, VIRGINIA 22408
 Phone 540 (703) 898-6025 / 898-9355

Drillers Signature John L. Danielson Pres
 Date 8/21/98 Representing JOHN L. DANIELSON, JR., INC.

Virginia Contractors License Number CLASS A 2701 014084A H/H WWC