

Commonwealth of Virginia

Uniform Water Well Completion Report

Geol. Log
Wheatland Homes Inc
P.O. Box 5234
Fredericksburg, VA 22408
286-0042 F 28-0371 R 572-2373
 Owner David Harrison
 Address 215 Woodview Drive
Fredericksburg, VA 22407
 Phone 373-9781
 Location Stafford Rotary # 2
Southman View Drive, off 238

Tax Map ID 39G-2
 VDI Permit SWP-97-311
 VWCB Permit _____
 VWCB ID _____
 County STAFFORD
8/25/97 Robert B. Wright

Well Classification IIIA _____ IIIB IIIC _____ IV _____
 * Well Data *

CRG

General Information

Drilling Method Med Rotary Date Completed 1/6/97
 Depth to Bedrock _____ Yield 15 (GPM)
 Static Water Level 140 Stabilized Water Level 180
 Well Disinfected (Y or N) _____ Disinfectant Used _____

Total Depth of Well 247
 Length of Test approx 3 Hrs.
 Natural Flow (Rate) _____
 Amount Used _____

Casing

From 1 To 215 From 235 To 247
 Size 4.5 Material PVC Size 4.5 Material PVC
 Weight/Schedule S.D.R. 17 Weight/Schedule S.D.R. 17

From _____ To _____
 Size _____ Material _____
 Weight/Schedule _____

Gravel Pack

From _____ To 247 From _____ To _____

Hole size

2 1/2" from 0 to 217 ft. " from _____ to _____ ft.

Grout

From 0 To 50' From _____ To _____

Bore Hole Size 2 1/2" Bore Hole Size _____ Bore Hole Size _____

Type Portland Type _____ Type _____

Method Pressure Grouting Method _____ Method _____

Water Zones or Screened Intervals

From 215 To 235 From 215' To 235' From _____ To _____

Mesh Size .020 Diam 4.5" (PVC) Mesh Size _____ Diam _____ Mesh Size _____ Diam _____

From _____ To _____ From _____ To _____ From _____ To _____

Mesh Size _____ Diam _____ Mesh Size _____ Diam _____ Mesh Size _____ Diam _____

* Use Data *

Private Well: Domestic Agricultural _____ Industrial _____ Monitoring _____
 Public Well: Community _____ Non Community _____

* Abandonment Information *

Bored or Dug Wells

Casing Removed, Y or N? _____
 If Y, Depth to which casing was removed: _____
 Depth and Type of Fill: _____
 Source of Fill _____
 Bentonite Plugs: From _____ to _____ From _____ to _____

Wells other than Bored Wells

Casing removed, Y or N? _____
 Depth to which casing was removed: _____
 Applicable, depth(s), and type of gravel/sand fill: _____
 Source of gravel or sand: _____
 Cement: From _____ to _____ From _____ to _____

Method of permanently marking location:

Installed watertight top
 Suggest setting pump @ approx. 200 ft.

Transaction - Private Water Supply System

5/1998 09:48 2860371

PAGE 02

Recap Log
Shepherd Home
David Norman
Shepherd Road #2
Shepherd
Southeast View Drive off #628

* Drillers Log *

Depth	Description of Formation or Sediment
0	10 Red Clay
10	30 yellow Sand
30	70 Black Sand
70	90 Sandy Gray Clay
90	130 Sand & Gravel
130	200 Sandy Gray Clay
200	210 Light Gray Sandy Clay
210	235 Gray Sand
235	247 Gray Clay

Remarks

(4 1/2")

DIAGRAM
(NOT TO SCALE)


+ Ft.

water high cap

Permits
1/7/98

Gravel packed

Approximate Water Zones
215-235

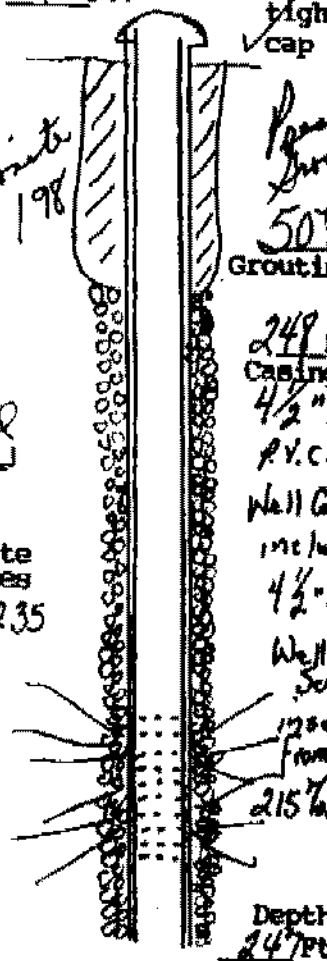

(Use additional Sheets if necessary)

I certify that the information contained here is true and that this well was installed and constructed in accordance with the permit and further that the well complies with all applicable state and local regulations, ordinances and laws.

Name JOHN L. DANIELSON, JR., INC.
 Address 4616 HOOD DRIVE
FREDERICKSBURG, VIRGINIA 22408
 Phone 548 (708) 898-6025 / 898-9355

Drillers Signature John L. Danielson, Pres
 Date 1/7/98 Representing JOHN L. DANIELSON, JR., INC.

Virginia Contractors License Number CLASS A 2701 014084A II/II WVC