

COMMONWEALTH OF VIRGINIA
UNIFORM WATER WELL COMPLETION REPORT

John Hodgson
P. O. Box 42163
Fredericksburg, VA 22404
Phone (804) 742-5805
Location Johnson Estates, Lot 8
Well Classification: IIIA IIIB XXXX IIIC IV

Tax Map ID 39-47H
VDH Permit SWP-98-408
VWCB Permit
VWCB ID
County Stafford

* Well Data *

General Information:

Drilling Method Rotary Date Completed 04/08/99 Total Depth of Well 190 ft.
Depth to Bedrock Yield 5 (GPM) Length of Test 4 hours
Static Water Level 90 Stblz'd Water Level 120 Natural Flow (rate)
Well disinfected Yes Disinfectant Used chlorine Amount Used 50 PPM

Casing:

<u>From 1 to 135</u>	<u>From 135 to 175</u>	<u>From to</u>
<u>Size 4 1/2" Mat'l PVC</u>	<u>Size 2" Mat'l Galv.</u>	<u>Size Mat'l</u>
<u>Weight/Schedule 40</u>	<u>Weight/Schedule 40</u>	<u>Weight/Schedule</u>

Gravel Pack:

<u>From to</u>	<u>From to</u>	<u>From to</u>
----------------	----------------	----------------

Grout:

<u>From 0 to 50</u>	<u>From 50 to 135</u>	<u>From 135 to 190</u>
<u>Bore Hole Size 8"</u>	<u>Bore Hole Size 7"</u>	<u>Bore Hole Size 3-7/8"</u>
<u>Type Benseal</u>	<u>Type</u>	<u>Type</u>
<u>Method Pressure</u>	<u>Method</u>	<u>Method</u>

Water Zones or Screened Intervals:


<u>From 175 to 190</u>	<u>From to</u>	<u>From to</u>
<u>Mesh Size 15 Diam. 2"</u>	<u>Mesh Size Diam.</u>	<u>Mesh Size Diam.</u>
<u>From to</u>	<u>From to</u>	<u>From to</u>
<u>Mesh Size Diam.</u>	<u>Mesh Size Diam.</u>	<u>Mesh Size Diam.</u>

* Use Data *

Private Well: Domestic XXXX Agricultural Industrial Monitoring
Public Well: Community Non-Community

* DRILLERS LOG *

DEPTH	DESCRIPTION OF FORMATION OR SEDIMENT
0- 10	Sand
10- 40	Sandstone
40-135	Gray clay and sand
135-142	Sand
142-170	Green and gray clay
170-190	Blue sand

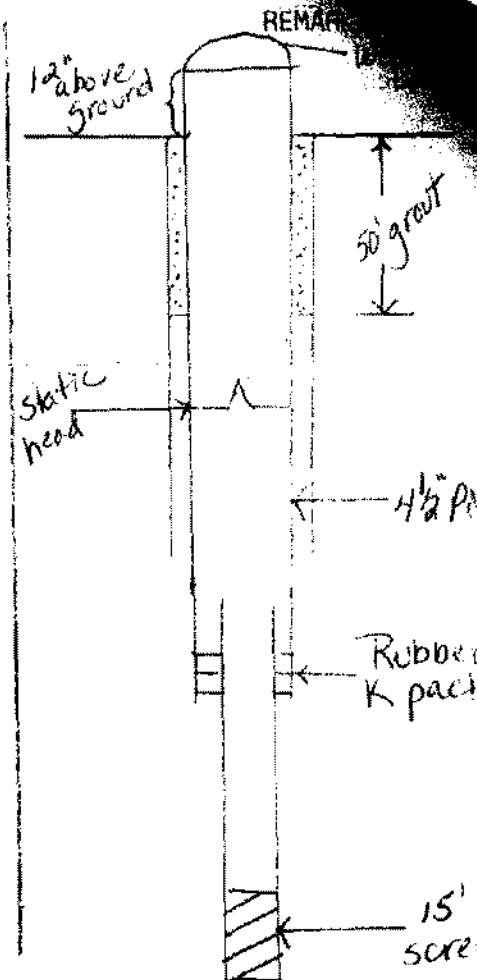

I certify that the information contained here is true and that this well was installed and constructed in accordance with the permit and further that the well complies with all applicable state and local regulations, ordinances and laws.

Name King George Drilling Service, Inc.

Address 861 Macedonia Lane
Colonial Beach, VA 22443

Phone (804) 224-9130

Driller's Signature _____

Date _____ Representing Kenneth M. Frank, Jr.

Virginia Contractor's License Number 2701 023065A

I certify that the information contained here is true and that this well was installed and constructed in accordance with the permit and further that the well complies with all applicable state and local regulations, ordinances and laws.

Name King George Drilling Service, Inc.

Address 861 Macedonia Lane
Colonial Beach, VA 22443

Phone (804) 224-9130

Driller's Signature _____

Date 4/8/99 Representing Kenneth M. Frank, Jr.

Virginia Contractor's License Number 2701 023065A