

COMMONWEALTH OF VIRGINIA  
UNIFORM WATER WELL COMPLETION REPORT

\_\_\_\_\_  
\_\_\_\_\_  
P.O. Box 42163  
\_\_\_\_\_  
Fredericksburg, VA 22404  
\_\_\_\_\_  
Phone (804) 742-4905  
\_\_\_\_\_  
Location Johnson Estates, Lot 2  
\_\_\_\_\_  
Well Classification: IIIA \_\_\_\_\_ IIIB XXXXX IIIC \_\_\_\_\_ IV \_\_\_\_\_

Tax Map ID 39-47B  
\_\_\_\_\_  
VDH Permit SWP-98-431  
\_\_\_\_\_  
WVCS Permit \_\_\_\_\_  
\_\_\_\_\_  
WVCS ID \_\_\_\_\_  
\_\_\_\_\_  
County Stafford  
\_\_\_\_\_

\* Well Data \*

General Information:

Drilling Method Rotary Date Completed 12/11/98 Total Depth of Well 150 ft.  
Depth to Bedrock Yield 30 (GPM) Length of Test 4 hours  
Static Water Level 90 Stblized Water Level 120 Natural Flow (rate) \_\_\_\_\_  
Well disinfected Yes Disinfectant Used chlorine Amount Used 50 PPM

Casing:

From 10 to 35 From 130 to 140 From \_\_\_\_\_ to \_\_\_\_\_  
Size 4 1/2" Mat PVC Size 2" Mat'l Galv. Size \_\_\_\_\_ Mat'l \_\_\_\_\_  
~~WVCS~~/Schedule 40 ~~WVCS~~/Schedule 40 Weight/Schedule \_\_\_\_\_

Gravel Pack:

From \_\_\_\_\_ to \_\_\_\_\_ From \_\_\_\_\_ to \_\_\_\_\_

Grout:

From 0 to 50 From 50 to 135 From 135 to 150  
Bore Hole Size 8" Bore Hole Size 7" Bore Hole Size 3-7/8"  
Type Benzoyl Type \_\_\_\_\_ Type \_\_\_\_\_  
Method Pressure Method \_\_\_\_\_ Method \_\_\_\_\_

Water Zones or Screened Intervals:


From 140 to 150 From \_\_\_\_\_ to \_\_\_\_\_ From \_\_\_\_\_ to \_\_\_\_\_  
Mesh Size 2" Mesh Size \_\_\_\_\_ Diam. Mesh Size \_\_\_\_\_ Diam.  
From \_\_\_\_\_ to \_\_\_\_\_ From \_\_\_\_\_ to \_\_\_\_\_ From \_\_\_\_\_ to \_\_\_\_\_  
Mesh Size \_\_\_\_\_ Diam. Mesh Size \_\_\_\_\_ Diam. Mesh Size \_\_\_\_\_ Diam.

\* Use Data \*

Private Well: Domestic XXXXX Agricultural \_\_\_\_\_ Industrial \_\_\_\_\_ Monitoring \_\_\_\_\_  
Public Well: Community \_\_\_\_\_ Non-Community \_\_\_\_\_

\* DRILLERS LOG \*

	DESCRIPTION OF FORMATION OR SEDIMENT
0-10	Sand
10-15	Red
15-40	Sand
40-55	Green sand brown clay
55-130	Pea gravel and sand
130-150	Blue sand

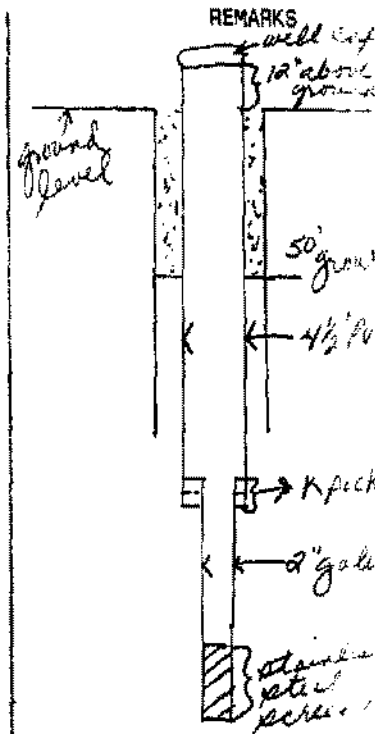

I certify that the information contained here is true and that this well was installed and constructed in accordance with the permit and further that the well complies with all applicable state and local regulations, ordinances and laws.

Name King George Drilling Service, Inc.  
 Address 861 Magnolia Lane  
Colonial Beach, VA 22443  
 Phone (804) 224-9130  
 Driller's Signature *John Gordon - Shepherd*  
 Date 12/11/98 Representing Kenneth M. Frank, Jr.  
 Virginia Contractor's License Number 2701 023065A

Fredericksburg, VA 22404 VWD FORM 1114  
 Phone (804) 622-5805 VWC9 ID \_\_\_\_\_  
 Location Johnson Estates, Lot 7 County Stafford  
 Well Classification IIIA IIIB XXXXX IIIC IV

\* Well Data \*

General Information  
 Drilling Method Rotary Date Completed 12/8/98 Total Depth of Well 191 ft.  
 Depth to Bedrock \_\_\_\_\_ Yield 10 (GPM) Length of Test 4 hours  
 Static Water Level 90 Stabilized Water Level 120 Natural Flow (rate) \_\_\_\_\_  
 Well disinfected Yes Disinfectant Used chlorine Amount Used 50 PPM

Casing:  
 From 11 to 176 From \_\_\_\_\_ to \_\_\_\_\_  
 Size 4 1/2\" Mat'l PVC Size 2\" Mat'l Galv. Size \_\_\_\_\_ Mat'l \_\_\_\_\_