

COMMONWEALTH OF VIRGINIA
UNIFORM WATER WELL COMPLETION REPORT

Western Virginia Land Development for
Jeremy Jones

Tax Map ID 39-47J

Address P. O. Box 42163

VDH Permit SWP-99-104

Fredericksburg, VA 22404

VWCB Permit _____

Phone (804) 742-5805

VWCB ID _____

Location Johnson Estates, Lot 9

County Stafford

Well Classification: IIIA IIIB XXXXX IIIC IV

* Well Data *

General Information:

Drilling Method Rotary Date Completed 4/8/99 Total Depth of Well 176 ft.
 Depth to Bedrock _____ Yield 10 (GPM) Length of Test 4 hours
 Static Water Level 90 Stblzed Water Level 120 Natural Flow (rate) _____
 Well disinfected Yes Disinfectant Used chlorine Amount Used 50 PPM

Casing:

From <u>1</u> to <u>152</u>	From <u>151</u> to <u>161</u>	From _____ to _____
Size <u>4½"</u> Mat'l <u>PVC</u>	Size <u>2"</u> Mat'l <u>Galv.</u>	Size _____ Mat'l _____
Weight /Schedule <u>40</u>	Weight /Schedule <u>40</u>	Weight/Schedule _____

Gravel Pack:

From _____ to _____	From _____ to _____	From _____ to _____
---------------------	---------------------	---------------------

Grout:

From <u>0</u> to <u>50</u>	From <u>50</u> to <u>152</u>	From <u>152</u> to <u>176</u>
Bore Hole Size <u>8"</u>	Bore Hole Size <u>7"</u>	Bore Hole Size <u>3-7/8"</u>
Type <u>Benseal</u>	Type _____	Type _____
Method <u>Pressure</u>	Method _____	Method _____

Water Zones or Screened Intervals:

From <u>161</u> to <u>176</u>	From _____ to _____	From _____ to _____
Mesh Size <u>15</u> Diam. <u>2"</u>	Mesh Size _____ Diam. _____	Mesh Size _____ Diam. _____
From _____ to _____	From _____ to _____	From _____ to _____
Mesh Size _____ Diam. _____	Mesh Size _____ Diam. _____	Mesh Size _____ Diam. _____


* Use Data *

Private Well: Domestic XXXXX Agricultural _____ Industrial _____ Monitoring _____
 Public Well: Community _____ Non-Community _____

0052
APR-28-82

* DRILLERS LOG *

DEPTH	DESCRIPTION OF FORMATION OR SEDIMENT
0- 20	Sand
20- 40	Sandstone
40-140	Gray clay and sand
140-152	Green and gray clay
152-176	White sand

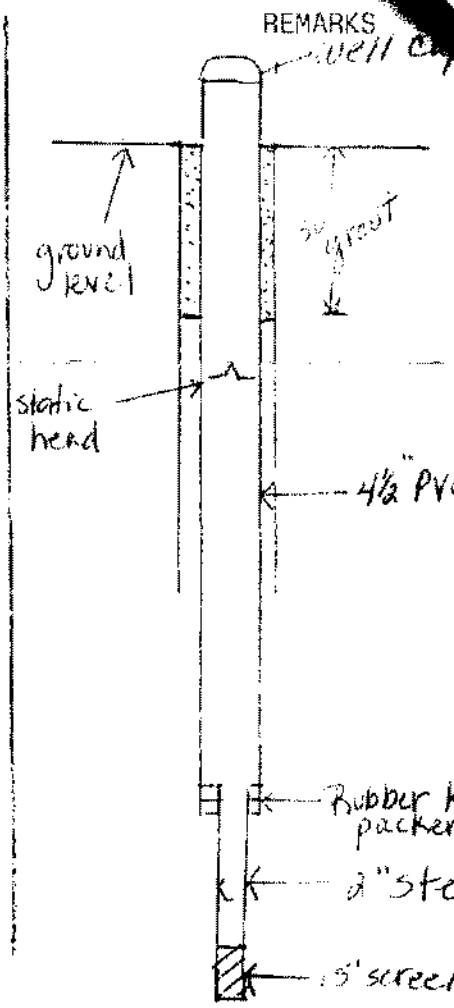

I certify that the information contained here is true and that this well was installed and constructed in accordance with the permit and further that the well complies with all applicable state and local regulations, ordinances and laws.

Name King George Drilling Service, Inc.
 Address 861 Macedonia Lane
Colonial Beach, VA 22443
 Phone (804) 224-9130
 Driller's Signature _____
 Date _____ Representing Kenneth M. Frank, Jr.
 Virginia Contractor's License Number 2701 023065A

I certify that the information contained here is true and that this well was installed and constructed in accordance with the permit and further that the well complies with all applicable state and local regulations, ordinances and laws.

Name King George Drilling Service, Inc.
 Address 861 Macedonia Lane
Colonial Beach, VA 22443
 Phone (804) 224-9130
 Driller's Signature John E. Shepherd
 Date 04/8/99 Representing Kenneth M. Frank, Jr.
 Virginia Contractor's License Number 2701 023065A