

Oakwood Homes
22444 Bob Mason / 898-7831
372-6324 (840-1829)
895-9273 (840-1830) Commonwealth of Virginia
Uniform Water Well Completion Report

Owner James L. Curran III
 Address 2313 Bellemeir Avenue
Cheverly Md. 20785
 Phone 1-301-4772-6999
 Location Montague Loop Lot 45 628 → L. on #619
 Well Classification IIIA IIIB IIIC IV
 * Well Data *

Tax Map ID 39-36
 VDH Permit W-93-106
 WVCB Permit _____
 WVCB ID _____
 County Stafford
4/18 Rt. Snyder
9/20 T. Thompson

General Information
 Drilling Method Air Rotary
 Depth to Bedrock _____
 Static Water Level 75
 Well Disinfected (Y or N) _____

Date Completed 8/18/93
 Yield 8 (GPM)
 Stabilized Water Level 170
 Disinfectant Used _____

Total Depth of Well 360'
 Length of Test 1 Hr.
 Natural Flow (Rate) _____
 Amount Used _____

Casing
 From +1 To 88
 Size 6 1/4 Material P.V.C.
 Weight/Schedule SDR 27

From 80 To 230
 Size 4 1/2 Material P.V.C.
 Weight/Schedule SDR 17

From 200 and 330
340 To 360
 Size 2" Material galvanized steel
 Weight/Schedule Sch 40

Gravel Pack
 From _____ To _____
 Hole size 10" from 0 to 80 ft.
 GROUT
 From 0 To 50'
 Bore Hole Size 10" 8/25/93
 Type Bentonite
 Method Pressure Grouting

From _____ To _____
 Hole size 6" from 80 to 230 ft.
 From _____ To _____
 Bore Hole Size _____
 Type _____
 Method _____

From _____ To _____
 Hole size 4" from 230 to 380 ft.
 From _____ To _____
 Bore Hole Size _____
 Type _____
 Method _____

Water Zones or Screened Intervals
 From 330 To 340
 Mesh Size .016 Diam 2" Stainless Steel
 From _____ To _____
 Mesh Size _____ Diam _____

From _____ To _____
 Mesh Size _____ Diam _____
*** Use Data ***

Private Well: Domestic Agricultural _____ Industrial _____ Monitoring _____
 Public Well: Community _____ Non Community _____

*** Abandonment Information ***

Bored or Dug Wells
 Casing Removed, Y or N?: _____
 If Y, Depth to which casing was removed: _____
 Depth and Type of Fill: _____
 Source of Fill _____
 Bentonite Plugs: From _____ to _____ From _____ to _____

Wells other than Bored Wells
 Casing removed, Y or N? _____
 Depth to which casing was removed: _____
 Applicable, depth(s), and type of gravel/sand fill: _____
 Source of gravel or sand: _____
 Cement: From _____ to _____ From _____ to _____

Method of permanently marking location: _____
 Installed watertight top
 Suggest setting pump @ approx. 190 ft.


P.O. # 128245

Department of Health of VA
 State

Paramount
Oakwood Home
James Curran
Stafford 619
Montague Loop

Drillers Log

Depth	Description of Formation or Sediment	Remarks
0	10	red clay
10	15	yellow sand
15	60	Blue Marl
60	75	Black sand
75	140	Blue clay
140	160	Brown clay
160	165	sand & gravel
165	210	Blue clay
210	215	gravel
215	332	Blue clay
332	338	sand
338	360	Brown clay

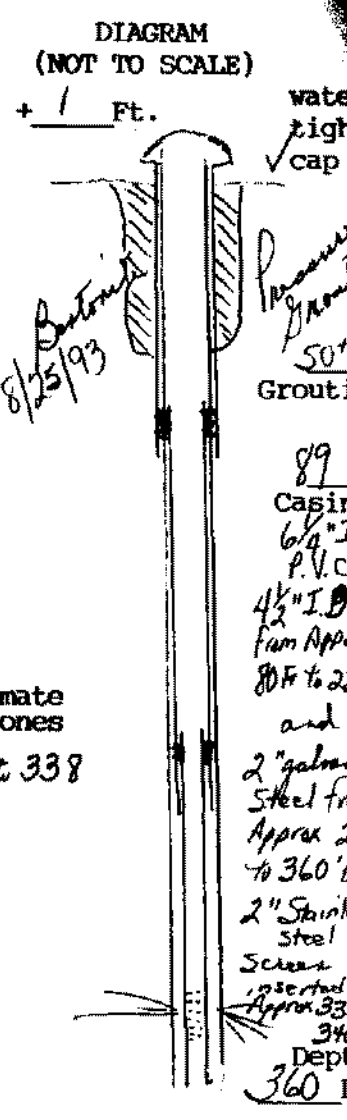

(User additional Sheets if necessary)

I certify that the information contained here is true and that this well was installed and constructed in accordance with the permit and further that the well complies with all applicable state and local regulations, ordinances and laws.

Name JOHN L. DANIELSON, JR., INC.
 Address 4616 HOOD DRIVE
FREDERICKSBURG, VIRGINIA 22408
 Phone (703) 898-6025 / 898-9355
 Drillers Signature John L. Danielson, Pres
 Date 8/25/93 Representing JOHN L. DANIELSON, JR., INC.
 Virginia Contractors License Number CLASS A 2701 014084A H/H WMC