

**Commonwealth of Virginia
Uniform Water Well Completion Report**

Owner Robert W. Waller
 Address 29 Greenridge Drive
Stafford, Va 22554
 Phone 659-6623 #703-221-1388
 Location # 628 -> L on # 608 -> 210 M&R on # 609 - 2/10 Miles
1830 (21174) As End of State Maintenance
 Well Classification IIIA IIIB ✓ IIIC IV
 Tax Map ID 39-117A
 VDH Permit WS-90-274
 VWCB Permit _____
 VWCB ID _____
 County Stafford
9/21/70 Karl Rudolph

* Well Data *

General Information
 Drilling Method Air Rotary
 Depth to Bedrock _____
 Static Water Level 90'
 Well Disinfected (Y or N) _____
 Date Completed 4/14/94
 Yield 25 (GPM)
 Stabilized Water Level 115
 Disinfectant Used _____
 Total Depth of Well 160'
 Length of Test 1 Hr.
 Natural Flow (Rate) _____
 Amount Used _____

Casing
 From +1 To 90
 Size 6 1/4" Material P.V.C.
 Weight/Schedule SDR 27
 From 85 To 130
 Size 4" Material P.V.C.
 Weight/Schedule Sch. 40
 From 150 To 160
 Size 4" Material _____
 Weight/Schedule _____

Gravel Pack
 From _____ To _____
 Hole size _____
10" from 0 to 55 ft.
 Grout
 From 0 To 50'
 Bore Hole Size 10"
 Type Bentonite
 Method Pressure Grouting
 From _____ To _____
 Hole size 7 7/8" from 55 to 90 ft.
 Grout
 From _____ To _____
 Bore Hole Size _____
 Type _____
 Method _____
 From _____ To _____
 Hole size 6 7/8" from 90 to 160 ft.
 Grout
 From _____ To _____
 Bore Hole Size _____
 Type _____
 Method _____

Water Zones or Screened Intervals
 From 130 To 150
 Mesh Size .020 Diam 4" P.V.C.
 From _____ To _____
 Mesh Size _____ Diam _____
 From _____ To _____
 Mesh Size _____ Diam _____
 From _____ To _____
 Mesh Size _____ Diam _____

* Use Data *

Private Well: Domestic Agricultural _____ Industrial _____ Monitoring _____
 Public Well: Community _____ Non Community _____

* Abandonment Information *

Bored or Dug Wells
 Casing Removed, Y or N? _____
 If Y, Depth to which casing was removed: _____
 Depth and Type of Fill: _____
 Source of Fill _____
 Bentonite Plugs: From _____ to _____ From _____ to _____


Wells other than Bored Wells
 Casing removed, Y or N? _____
 Depth to which casing was removed: _____
 Applicable, depth(s), and type of gravel/sand fill: _____
 Source of gravel or sand: _____
 Cement: From _____ to _____ From _____ to _____

Method of permanently marking location: _____
 Installed watertight top
 suggest setting pump @ approx. 130 ft.
you will encounter 4" casing @ approx 85 Ft.
940398 - suggest keeping centralizers & torque arrestors out of 4" casing.
 L.T.

Robert W. Maurest. Walker

Stafford East end of State Mhnt. on #609
 628 → L. on 608 → R. on 609
 * Drillers Log *

Depth	Description of Formation or Sediment	Remarks
0	10	Sandy Red Clay
10	30	Yellow Sand
30	50	Blue Marl
50	90	Black Sand
90	130	Blue Clay
130	145	Grey Sand
145	160	Brown clay

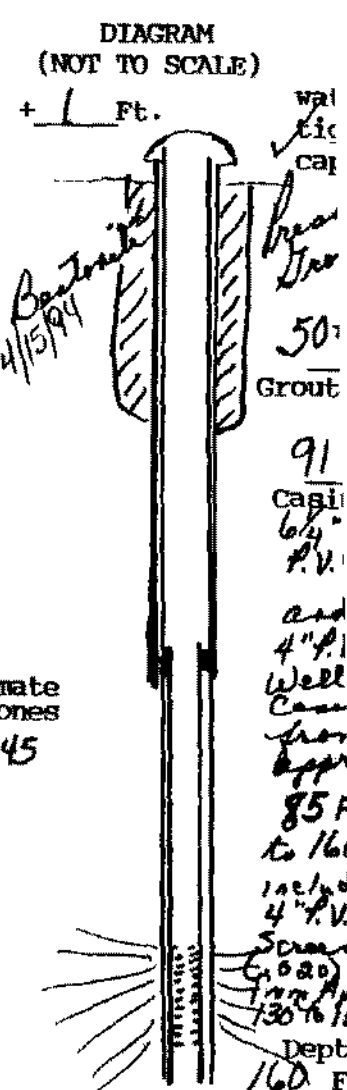

Approximate Water Zones
130 to 145



(Use additional Sheets if necessary)

I certify that the information contained here is true and that this well was installed and constructed in accordance with the permit and further that the well complies with all applicable state and local regulations, ordinances and laws.

Name JOHN L. DANIELSON, JR., INC.
 Address 4616 HOOD DRIVE
FREDERICKSBURG, VIRGINIA 22408
 Phone (703) 898-6025 / 898-9355

Drillers Signature John L. Danielson, Jr.
 Date 4/15/94 Representing JOHN L. DANIELSON, JR., INC.

Virginia Contractors License Number CLASS A 2701 014084A H/H WWC