

5
 Construction
 3512
 22110
 357-7347

Commonwealth of Virginia
 Uniform Water Well Completion Report

Owner Clayton Boyonny
 Address P.O. Box 0 1022
Stafford, Va. 22554
 Phone 757-8828
 Location #628 (*1 -> 628 -> across RR Bridge / on Right
183D
 Well Classification IIIA IIIB IIIC IV

Tax Map ID 39-112 B
 VDH Permit WS-91-220
 VWCB Permit _____
 VWCB ID _____
 County STAFFORD
11/27/91 Robert Snyder
12/21/91 T. T. Thompson

* Well Data *

General Information
 Drilling Method Air Rotary
 Depth to Bedrock _____
 Static Water Level 25
 Well Disinfected (Y or N) _____

Date Completed 4/14/94
 Yield 30 (GPM)
 Stabilized Water Level 60
 Disinfectant Used _____

Total Depth of Well 140'
 Length of Test Approx 1 Hr.
 Natural Flow (Rate) _____
 Amount Used _____

Casing
 From +1 To 70
 Size 6 1/4" Material P.V.C.
 Weight/Schedule SDR 27

From 60 To 100
 Size 4" Material P.V.C.
 Weight/Schedule Sch. 40

From 120 To 140
 Size 4" Material P.V.C.
 Weight/Schedule Sch. 40

Gravel Pack
 From _____ To _____
 Hole size 10" from 0 to 50 ft.
 Grout
 From 0 To 50+
 Bore Hole Size 10"
 Type Bentonite
 Method Pressure Grouting

From _____ To _____
 Hole size 7 7/8" from 50 to 70 ft.
 Grout
 From _____ To _____
 Bore Hole Size _____
 Type _____
 Method _____

From _____ To _____
 Hole size 6 1/8" from 70 to 140 ft.
 Grout
 From _____ To _____
 Bore Hole Size _____
 Type _____
 Method _____

Water Zones or Screened Intervals
 From 100 To 120
 Mesh Size .020 Diam 4" P.V.C.
 From _____ To _____
 Mesh Size _____ Diam _____

approx water zone
 From 105 To 115
 Mesh Size _____ Diam _____
 From _____ To _____
 Mesh Size _____ Diam _____

From _____ To _____
 Mesh Size _____ Diam _____
 From _____ To _____
 Mesh Size _____ Diam _____

* Use Data *

Private Well: Domestic Agricultural _____ Industrial _____ Monitoring _____
 Public Well: Community _____ Non Community _____

* Abandonment Information *

Bored or Dug Wells
 Casing Removed, Y or N? _____
 If Y, Depth to which casing was removed: _____
 Depth and Type of Fill: _____
 Source of Fill _____
 Bentonite Plugs: From _____ to _____ From _____ to _____


Wells other than Bored Wells
 Casing removed, Y or N? _____
 Depth to which casing was removed: _____
 Applicable, depth(s), and type of gravel/sand fill: _____
 Source of gravel or sand: _____
 Cement: From _____ to _____ From _____ to _____

Method of permanently marking location:
 Installed watertight top.
 Suggest setting pump @ approx. 80 ft.
You will encounter 4" casing @ approx 60 ft.
Suggest keeping torque wrenches & centralizers out of 4" casing
940290
AH Jacoby

State of Virginia
 Department of Health
 State Health Service
 201
 State Health Service
 State of Virginia
 Department of Health
 State Health Service
 201

John Bland
 Bland Construction
 Clayton Boring
 Staffed 628
 #1 -> 628 / Across RR. Bridge and R.
 Drillers Log

Depth	Description of Formation or Sediment	Remarks
0	10	Sandy Red Clay
10	30	Yellow Sand
30	50	Blue Clay
50	69	Sandy Blue Clay
69	105	Brown Clay
105	125	Grey Sand
125	140	Brown clay

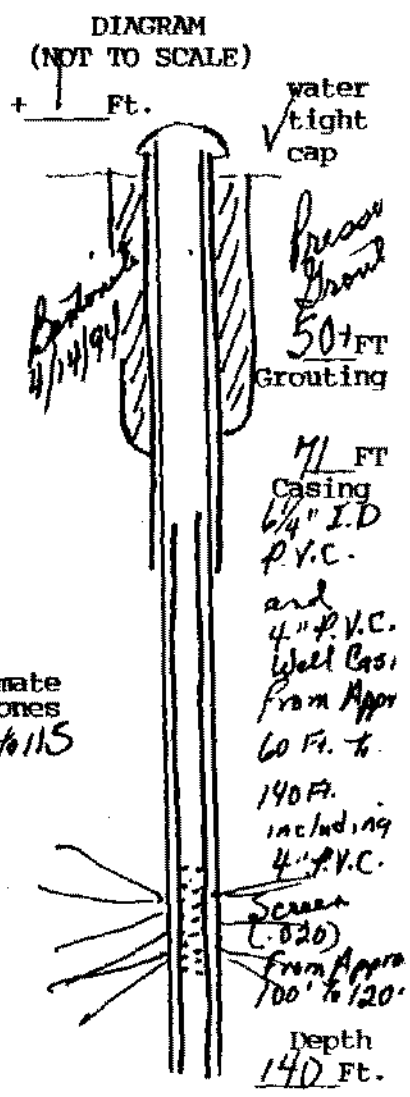

Approximate Water Zones 105 to 115



(User additional Sheets if necessary)

I certify that the information contained here is true and that this well was installed and constructed in accordance with the permit and further that the well complies with all applicable state and local regulations, ordinances and laws.

Name JOHN L. DANIELSON, JR., INC.
 Address 4616 HOOD DRIVE
FREDERICKSBURG, VIRGINIA 22408
 Phone (703) 898-6025 / 898-9355
 Drillers Signature [Signature]
 Date 4/14/94 Representing JOHN L. DANIELSON, JR., INC.
 Virginia Contractors License Number CLASS A 2701 014084A H/H WWC