

Commonwealth of Virginia
Uniform Water Well Completion Report

Precision Drivwell & Constr.
Address 150 Gold Mine Rd.
Fredericksburg, VA 22406
Phone (703) 373-7991
Location 1822 Brooke Rd.
Well Classification IIIA IIIB IIIC IV

Tax Map ID 39-129.B
VMI Permit WS-93-222
VMCB Permit
VMCB ID
County Stafford

* Well Data *

General Information
Drilling Method Rotary Date Completed 1-7-94 Total Depth of Well 172 FT.
Depth to Bedrock Yield 50 (GPM) Length of Test 4 HRS.
Static Water Level 30 Stblzd Water Level 60 Natural Flow (rate)
Well Disinfected (Y/N) Y Disinfectant Used Chlorine Amount Used 50 PPM

Casing
From 1 to 160 From 152 to 162 From to
Size 4 1/2" Material PVC Size 2" Material GALV. Size Material
Weight/Schedule 40 Weight/Schedule 40 Weight/Schedule

Gravel Pack
From to From to From to

Grout
From 0 to 50 From to From to
Bore Hole Size 8" Bore Hole Size Bore Hole Size
Type Bentonite Clay Type Type
Method Pressure Method Method

Water Zones or Screened Intervals
From 162 to 172 From to From to
Mesh Size 15 Diam. 2" Mesh Size Diam. Mesh Size Diam.
From to From to From to
Mesh Size Diam. Mesh Size Diam. Mesh Size Diam.

* Use Data *

Private Well: Domestic ✓ Agricultural Industrial Monitoring
Public Well: Community Non Community


* Abandonment Information *

Bored or Dug Wells	Wells other than Bored Wells
Casing Removed, Y or N?: <u> </u>	Casing Removed, Y or N?: <u> </u>
If Y, Depth Removed: <u> </u>	If Y, Depth Removed: <u> </u>
Depth and Type of Fill: <u> </u>	Depth and type of Fill: <u> </u>
Source of Fill: <u> </u>	Source of Gravel or Sand: <u> </u>
Bentonite Plugs: From <u> </u> to <u> </u>	Cement: From <u> </u> to <u> </u>
From <u> </u> to <u> </u>	From <u> </u> to <u> </u>

Method of permanently marking location:

DRILLERS LOG

DEPTH	DESCRIPTION OF FORMATION OR SEDIMENT
0 - 10	Sand, gravel & clay
10 - 40	Black sand & shells
40 - 90	Sandstone
90 - 160	Gray clay & sandstone
160 - 172	Blue & white sand

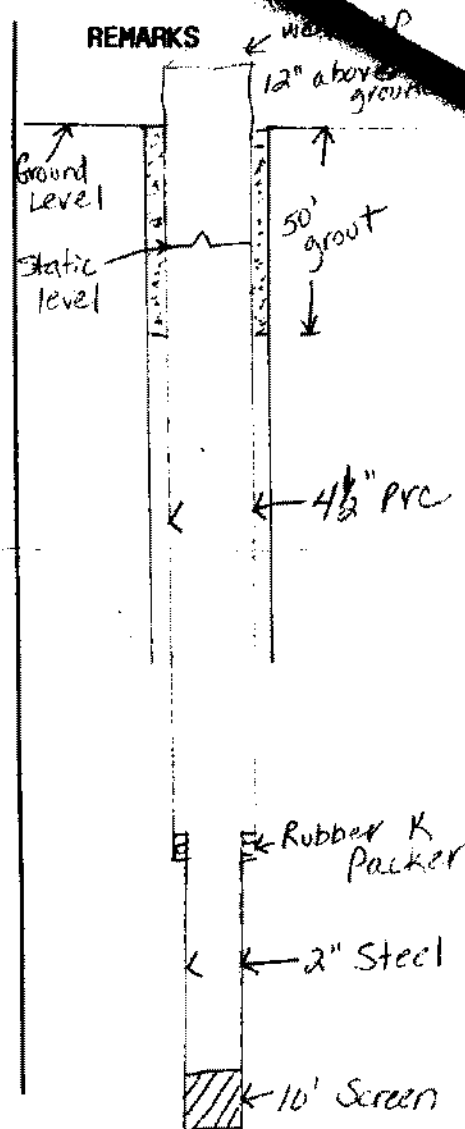

I certify that the information contained here is true and that this well was installed and constructed in accordance with the permit and further that the well complies with all applicable state and local regulations, ordinances and laws.

Name King George Drilling
 Address Rt. 1 - Box 86K
Colonial Beach, VA 22443
 Phone 1804/ 224-9130

Driller's Signature John Gordon - Shepherd
 Date 1-7-94 Representing Kenneth Frank, Jr.

Virginia Contractors License Number 023065