

Bridge Drive
Ch. 2254
752-2475

Commonwealth of Virginia
Uniform Water Well Completion Report

Joe Sale

Tax Map ID 40A-1
VDH Permit 189-90-27
VWCB Permit _____
VWCB ID _____
County Stafford
3-20-90 Ark. Synclinal
3-22-90 A.A. Durr

Phone _____
Location Wendover #1 Stafford 608
Approx 1 m. E. of Intersection of 638/628
Well Classification IIIA _____ IIIB IIIC _____ IV _____
182A * Well Data *

General Information

Drilling Method Air Rotary
Depth to Bedrock _____
Static Water Level 80'
Well Disinfected (Y or N) _____

Date Completed 8/4/93
Yield 20 (GPM)
Stabilized Water Level 140
Disinfectant Used _____

Total Depth of Well 220
Length of Test 1 Hr.
Natural Flow (Rate) _____
Amount Used _____

Casing
From +1 To 79
Size 6 1/4" Material P.V.C.
Weight/Schedule SDR 27

From 79 To 119
Size 6 1/4" Material P.V.C.
Weight/Schedule SDR 21

115' and 195
From 215 To 220
Size 4" Material P.V.C.
Weight/Schedule Schedule 40

Gravel Pack

From _____ To _____

From _____ To _____

From _____ To _____

Hole size
10" from 0 to 60 ft.

7 7/8" from 60 to 119 ft.

6" from 119 to 220 ft.

Grout
From 0 To 50'
Bore Hole Size 10" 8/14/93
Type Bentonite
Method Pressure Grouting

From _____ To _____
Bore Hole Size _____
Type _____
Method _____

From _____ To _____
Bore Hole Size _____
Type _____
Method _____

Water Zones or Screened Intervals

From 195 To 215
Mesh Size .020 Diam 4" (P.V.C.)
From _____ To _____
Mesh Size _____ Diam _____

approx water zone
From 200' To 208'
Mesh Size _____ Diam _____
From _____ To _____
Mesh Size _____ Diam _____

From _____ To _____
Mesh Size _____ Diam _____
From _____ To _____
Mesh Size _____ Diam _____

* Use Data *

Private Well: Domestic Agricultural _____ Industrial _____ Monitoring _____
Public Well: Community _____ Non Community _____

* Abandonment Information *

Bored or Dug Wells

Casing Removed, Y or N?: _____
If Y, Depth to which casing was removed: _____
Depth and Type of Fill: _____
Source of Fill _____
Bentonite Plugs: From _____ to _____ From _____ to _____

Wells other than Bored Wells

Casing removed, Y or N?: _____
Depth to which casing was removed: _____
Applicable, depth(s), and type of gravel/sand fill: _____
Source of gravel or sand: _____
Cement: From _____ to _____ From _____ to _____

Method of permanently marking location: _____

Installed watertight top
Suggest setting pump @ approx. 160 ft.


Well telescoped to 4" @ approx 115 ft.
Suggest keeping torque arrestors & centralized out of 4" casing.

Thomas Carter / Carter Construction
For Sale
Wandermere #1
Stafford 608

* Drillers Log *

Depth Description of Formation or Sediment Remarks

0	10	Red Clay
10	20	yellow sand
20	60	Blue Marl
60	110	Black Sand
110	200	Brown Clay
200	208	Grey sand - water zone
208	220	Blue Clay

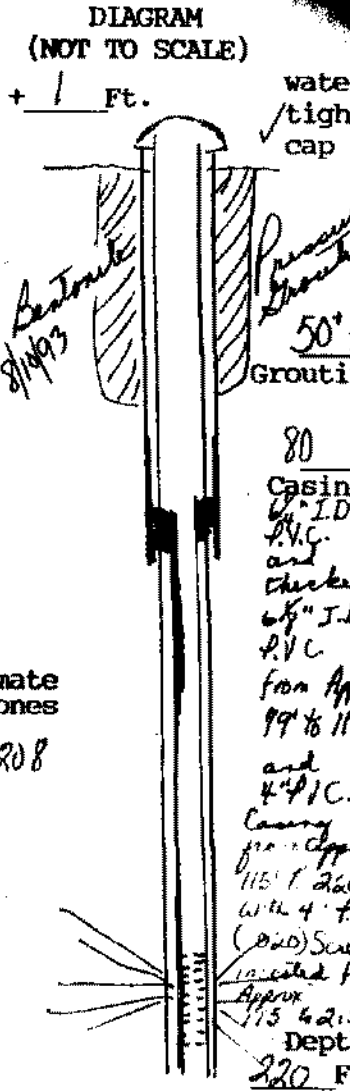

Approximate Water Zones
 200 to 208

(User additional Sheets if necessary)

I certify that the information contained here is true and that this well was installed and constructed in accordance with the permit and further that the well complies with all applicable state and local regulations, ordinances and laws.

Name JOHN L. DANIELSON, JR., INC.
 Address 4616 HOOD DRIVE
FREDERICKSBURG, VIRGINIA 22408
 Phone (703) 898-6025 / 898-9355

Drillers Signature [Signature]
 Date 8/10/93 Representing JOHN L. DANIELSON, JR., INC.

Virginia Contractors License Number CLASS A 2701 014084A H/H WMC