

Keeping you in the flow of things



Commonwealth of Virginia Uniform Water Well Completion Report

Owner SYG Associates, Inc.
Address 9701 Burrewell Rd.
Nokesville, VA 20181
Phone _____
Location Poplar Hills Lot # 21

Tax Map ID 48A-21
VDH Permit SWP-01-153
VWCB Permit _____
VWCB ID _____
County Stafford

Well Classification IIIA _____ IIIB IIIC _____ IV _____
* Well Data *

General Information
Drilling Method Air Rotary
Depth to Bedrock 70'
Static Water Level 40'
Well Disinfected (Y or N) N

Date Completed 6/28/01
Yield 20+ (GPM)
Stabilized Water Level _____
Disinfectant Used _____

Total Depth of Well 240'
Length of Test 1 hr.
Natural Flow (Rate) N
Amount Used _____

Casing From +1 1/2' To 78 1/2'
Size 6 3/4" ID Material PVC
Weight/Schedule 3.491 # per ft.
.250 wall

From 60 To 160'
Size 4 1/2" ID Material PVC
Weight/Schedule 2.788 # per ft.
.291 wall

From _____ To _____
Size _____ Material _____
Weight/Schedule _____

Gravel Pack From _____ To _____
Hole size _____ from _____ to _____ ft.

From _____ To _____
" from _____ to _____ ft.

From _____ To _____
" from _____ to _____ ft.

From 60' To 0
Bore Hole Size 10" x 7 7/8"
Type Bentonite EZ Seal
Method pressure grout from bottom to top

From 78 1/2' To 60'
Bore Hole Size 10" x 7 7/8"
Type Natural cave-in
Method backfill

From _____ To _____
Bore Hole Size _____
Type _____
Method _____

Water Zones or Screened Intervals
From 160' To 240'
Mesh Size 20 Diam 4 1/2"
From _____ To _____
Mesh Size _____ Diam _____

From _____ To _____
Mesh Size _____ Diam _____
* Use Data *

Private Well Domestic Agricultural _____ Industrial _____ Monitoring _____
Public Well Community _____ Non Community _____

* Abandonment Information *

Bored or Cug Wells
Casing Removed, Y or N? _____
Depth to which casing was removed: _____
Depth and Type of Fill: _____
Source of Fill: _____
Bentonite Plugs From _____ to _____ From _____ to _____

Wells other than Bored Wells
Casing removed, Y or N? _____
Depth to which casing was removed: _____
Applicable, depth(s), and type of gravel/sand fill: _____
Source of gravel or sand: _____
Cement: From _____ to _____ From _____ to _____



Method of permanently marking location: Installed watertight top

Depth

Description of Formation or Sediment

Remarks

0	10'	brown sandy clay
10'	15'	TAN sandy clay
15'	40'	TAN/Grey sandy clay
40'	70'	grey sandy clay
70'	190'	grey/green clay
190'	240'	brown sand

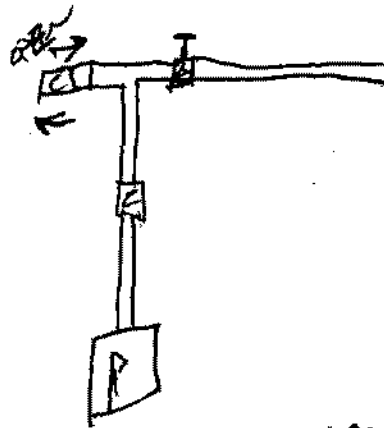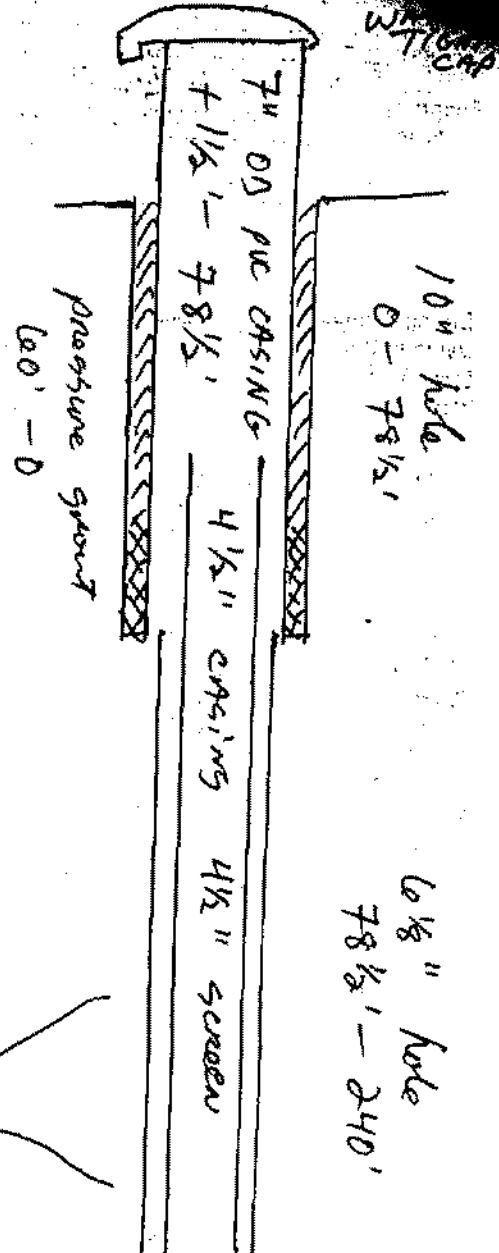

190' - 220'
20+ GPM

(User additional Sheets if necessary)

I hereby certify that the information contained here is true and that this well was installed and constructed in accordance with the permit and that the well complies with all applicable state and local regulations, ordinances and laws.

By ARTESIAN WATER WELLS, INC.
 Address 11412 GORDON RD
PURGE VA 22407
 Phone 540-785-8163

Driller's Signature Wade N. Smith
 Date 6/28/01 Representing A.W.W.I.

Driller's License Number 2705-046112