

Commonwealth of Virginia
Uniform Water Well Completion Report



Owner SVG Assoc.
Address 9701 Burwell Rd.
Notegville, VA 20181
Phone (703) 754-1714
Location Poplar Hills Lot # 28

Tax Map ID 48A-28
VDH Permit SWP-01-156
VWCB Permit _____
VWCB ID _____
County Stafford

Well Classification IIIA IIIB IIIC IV
* Well Data *

General Information
Drilling Method Air Rotary Date Completed 9/17/01 Total Depth of Well 100'
Depth to Bedrock 60' Yield 30+ (GPM) Length of Test 1 hr.
Static Water Level 75' Stabilized Water Level _____ Natural Flow (Rate) N
Well Disinfected (Y or N) N Disinfectant Used _____ Amount Used _____

Casing
From +1 1/2' To 68 1/2' From 60' To 80' From _____ To _____
Size 6 1/4" (50) Material PVC Size 4 1/2" Material PVC Size _____ Material _____
Weight/Schedule 3.491 lb per ft. Weight/Schedule 2.788 # per ft. Weight/Schedule _____
.250 wall .291 wall

Gravel Pack
From _____ To _____ From _____ To _____ From _____ To _____
Hole size _____ " from _____ to _____ ft. _____ " from _____ to _____ ft. _____ " from _____ to _____ ft.
Drill Bit _____ From _____ To _____ From _____ To _____ From _____ To _____
Bore Hole Size 10" x 68 1/2' Bore Hole Size _____ Bore Hole Size _____
Type Bentonite E-z seal Type _____ Type _____
Method pressure grout from bottom to top Method _____ Method _____

Water Zones or Screened Intervals
From 80' To 100' From _____ To _____ From _____ To _____
Mesh Size .020 Diam 4 1/2" Mesh Size _____ Diam _____ Mesh Size _____ Diam _____
From _____ To _____ From _____ To _____ From _____ To _____
Mesh Size _____ Diam _____ Mesh Size _____ Diam _____ Mesh Size _____ Diam _____

* Use Data *

Private Well Domestic Agricultural _____ Industrial _____ Monitoring _____
Public Well Community _____ Non Community _____

* Abandonment Information *

Bored or Dug Wells
Casing Removed, Y or N? _____
If Y, Depth to which casing was removed: _____
Depth and Type of Fill: _____
Source of Fill _____
Bentonite Plugs From _____ to _____ From _____ to _____


Wells other than Bored Wells
Casing removed, Y or N? _____
Depth to which casing was removed: _____
Applicable, depth(s), and type of gravel/sand fill: _____
Source of gravel or sand: _____
Cement: From _____ to _____ From _____ to _____

Method of permanently marking location: Installed watertight top

Drillers Log

NOT TO SCALE

Depth	Description of Formation or Sediment
0 25'	BROWN SANDY CLAY
25' 60'	Grey SANDY CLAY
60' 85'	grey / green CLAY hard
85' 100'	white sand

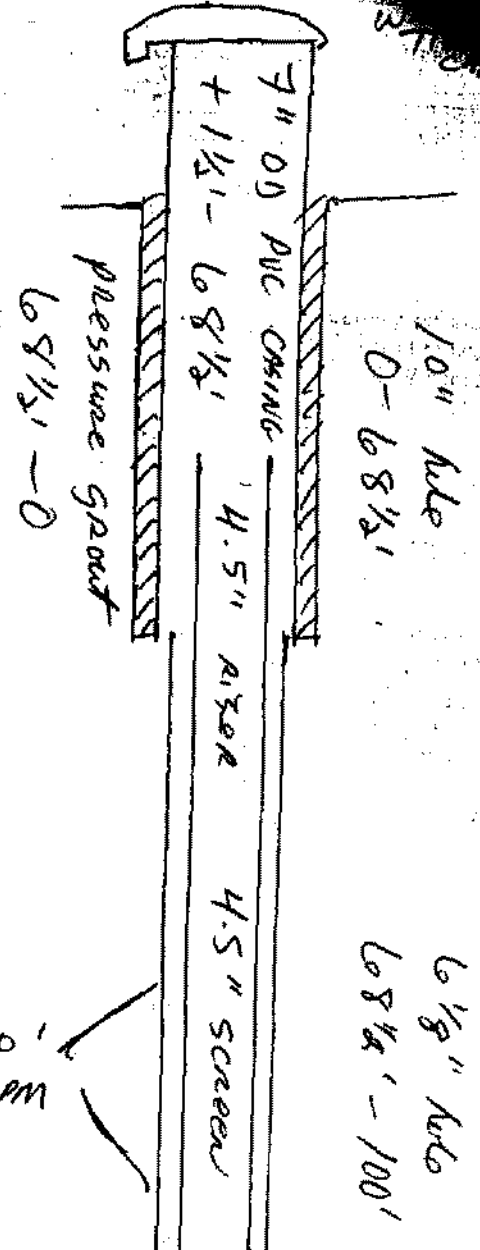

85'-100'
30+ GPM

(Use additional Sheets if necessary)

I certify that the information contained here is true and that this well was installed and constructed in accordance with the permit and general that the well complies with all applicable state and local regulations, ordinances and laws.

Name ARTESIAN WATER WELLS, INC.
 Address 11412 GORDON RD
PURCELL VA 22407
 Phone 540-782-8163

Drillers Signature Wade N. Smith
 Date 9/17/01 Representing A.W.W.

Virginia Contractors Licence Number 2705-046112