

Commonwealth of Virginia  
Uniform Water Well Completion Report



Well No: SYG Assoc. Inc.  
 Address: 2741 Burwell Rd.  
Nokesville VA 20181  
 Phone: (703) 754-1914  
 Location: Aples Hills Lot # 4

Tax Map ID: 406-1-4  
 VDH Permit: SWP-01-256  
 VWCS Permit: \_\_\_\_\_  
 VWCS ID: \_\_\_\_\_  
 County: Stafford

Well Classification: IIIA \_\_\_\_\_ IIIB  IIIC \_\_\_\_\_ IV \_\_\_\_\_  
 \* Well Data \*

General Information  
 Drilling Method: Big Rig Date Completed: 9/04/01 Total Depth of Well: 120'  
 Depth to Bedrock: 30' Yield: 30+ (GPM) Length of Test: 1 hr.  
 Static Water Level: 30' Stabilized Water Level: \_\_\_\_\_ Natural Flow (Rate): N  
 Disinfectant Used: \_\_\_\_\_ Amount Used: \_\_\_\_\_

casing  
 From 1 1/2' To 78 1/2' From 60' To 80' From \_\_\_\_\_ To \_\_\_\_\_  
 Material: PVC Material: PVC Size: \_\_\_\_\_ Material: \_\_\_\_\_  
 Weight/Schedule: 250 wall Weight/Schedule: 291 wall Weight/Schedule: \_\_\_\_\_

Screen Pack  
 From \_\_\_\_\_ To \_\_\_\_\_ From \_\_\_\_\_ To \_\_\_\_\_ From \_\_\_\_\_ To \_\_\_\_\_  
 Mesh Size: \_\_\_\_\_ " from \_\_\_\_\_ to \_\_\_\_\_ " from \_\_\_\_\_ to \_\_\_\_\_  
 Screen: 78 1/2' To 0 From \_\_\_\_\_ To \_\_\_\_\_  
 Mesh Size: 10 x 30 Mesh Size: \_\_\_\_\_  
 Type: BENTONITE F-2 seal Bore Hole Size: \_\_\_\_\_  
 Method: pressure grout from bottom to top Method: \_\_\_\_\_

Water Zones or Screened Intervals  
 From 80' To 120' From \_\_\_\_\_ To \_\_\_\_\_ From \_\_\_\_\_ To \_\_\_\_\_  
 Mesh Size: 20 Mesh Size: \_\_\_\_\_ Mesh Size: \_\_\_\_\_  
 From \_\_\_\_\_ To \_\_\_\_\_ From \_\_\_\_\_ To \_\_\_\_\_  
 Mesh Size: \_\_\_\_\_ Mesh Size: \_\_\_\_\_ Mesh Size: \_\_\_\_\_

\* Use Data \*

Primary Well: Domestic  Agricultural \_\_\_\_\_ Industrial \_\_\_\_\_ Monitoring \_\_\_\_\_  
 Public Well: Community \_\_\_\_\_ Non-Community \_\_\_\_\_

\* Abandonment Information \*

Wells or Big Wells: Casing removed, Y or N? \_\_\_\_\_  
 Depth to which casing was removed: \_\_\_\_\_  
 Depth and Type of Fill: \_\_\_\_\_  
 Source of Fill: \_\_\_\_\_  
 Distance From \_\_\_\_\_ to \_\_\_\_\_  
 Wells other than Bored Wells: Casing removed, Y or N? \_\_\_\_\_  
 Depth to which casing was removed: \_\_\_\_\_  
 Applicable, depth(s), and type of gravel/sand fill: \_\_\_\_\_  
 Source of gravel or sand: \_\_\_\_\_  
 Cement: From \_\_\_\_\_ to \_\_\_\_\_ From \_\_\_\_\_ to \_\_\_\_\_

Method of permanently marking location:  
1 Installed watertight cap

RECEIVED  
 SEP 25 2001

RECEIVED  
 SEP 25 2001


RECEIVED  
 SEP 25 2001

Dillers Log NOT TO SCALE

Depth Description of Formation or Sediment

Remarks

0	10'	brown sandy clay
10'	40'	tan sandy clay
40'	70'	gray sandy clay
70'	9'	gray / green clay
	120'	brown coarse sand w/ shells

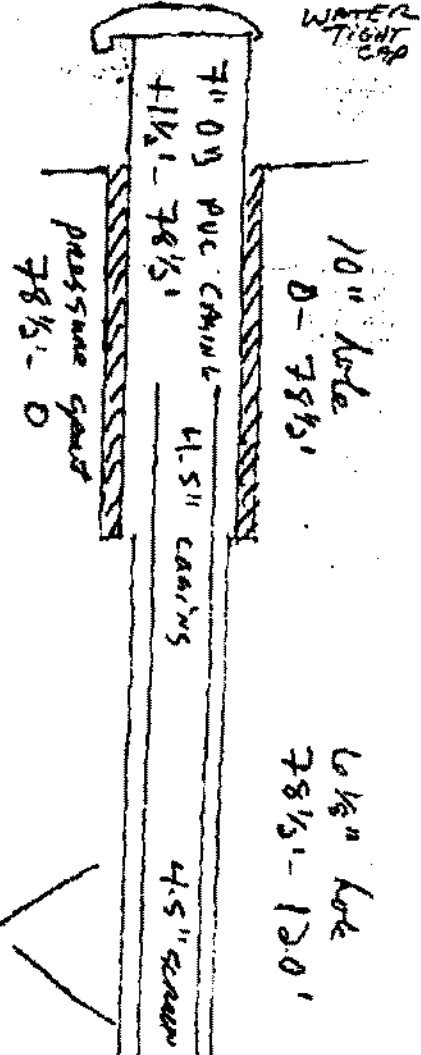

90'-120'  
30+ GPM

(Use additional sheets if necessary)

I hereby certify that the information contained here is true and that this well was installed and constructed in accordance with the permits and laws and that the well complies with all applicable state and local regulations, ordinances and laws.

Company: ARTESIAN WATER WELLS, INC.  
 Address: 11412 GARDNER RD  
BRUCE VT 05247  
 Phone: 802-735-8163  
 Date: 9/4/01 Recessing  
 License Number: 2925-04612