



Commonwealth of Virginia  
Uniform Water Well Completion Report

Owner SYG Associates, Inc.  
Address 9701 Burwell Rd.  
Nokesville, VA 20181  
Phone \_\_\_\_\_  
Location Poplar Hills Sec. 1 Lot # 11

Tax Map ID 40-B-11  
VDH Permit SWP-01-258  
VWCB Permit \_\_\_\_\_  
VWCB ID \_\_\_\_\_  
County Stafford

Well Classification IIIA \_\_\_\_\_ IIIB  IIIC \_\_\_\_\_ IV \_\_\_\_\_  
\* Well Data \*

General Information

Drilling Method Air Rotary Date Completed 8/31/01  
Depth to Bedrock 50' Yield 20 + (GPM)  
Static Water Level 120' Stabilized Water Level \_\_\_\_\_  
Well Disinfected (Y or N) N Disinfectant Used \_\_\_\_\_

Total Depth of Well 200'  
Length of Test 1 hr.  
Natural Flow (Rate) N  
Amount Used \_\_\_\_\_

Casing From +1 1/2' To 68 1/2'  
Size 6 3/4" ID Material PVC  
Weight/Schedule 3.491 # per ft.  
.250 wall

From 60' To 160'  
Size 4 1/2" Material PVC  
Weight/Schedule 2.786 # per ft.  
.291 wall

From \_\_\_\_\_ To \_\_\_\_\_  
Size \_\_\_\_\_ Material \_\_\_\_\_  
Weight/Schedule \_\_\_\_\_

Gravel Pack

From \_\_\_\_\_ To \_\_\_\_\_ From \_\_\_\_\_ To \_\_\_\_\_ From \_\_\_\_\_ To \_\_\_\_\_

Hole size

\_\_\_\_\_ " from \_\_\_\_\_ to \_\_\_\_\_ ft. \_\_\_\_\_ " from \_\_\_\_\_ to \_\_\_\_\_ ft. \_\_\_\_\_ " from \_\_\_\_\_ to \_\_\_\_\_ ft.

Drill

From 68 1/2' To 0 From \_\_\_\_\_ To \_\_\_\_\_ From \_\_\_\_\_ To \_\_\_\_\_

Bore Hole Size 10" x 6 1/2" Bore Hole Size \_\_\_\_\_ Bore Hole Size \_\_\_\_\_  
Type Openite E-2 set Type \_\_\_\_\_ Type \_\_\_\_\_  
Method pressure grout from bottom to top Method \_\_\_\_\_ Method \_\_\_\_\_

Water Zones or Screened Intervals

From 160' To 200' From \_\_\_\_\_ To \_\_\_\_\_ From \_\_\_\_\_ To \_\_\_\_\_

Mesh Size .530 Diam 4 1/2" Mesh Size \_\_\_\_\_ Diam \_\_\_\_\_ Mesh Size \_\_\_\_\_ Diam \_\_\_\_\_

From \_\_\_\_\_ To \_\_\_\_\_ From \_\_\_\_\_ To \_\_\_\_\_ From \_\_\_\_\_ To \_\_\_\_\_  
Mesh Size \_\_\_\_\_ Diam \_\_\_\_\_ Mesh Size \_\_\_\_\_ Diam \_\_\_\_\_ Mesh Size \_\_\_\_\_ Diam \_\_\_\_\_

\* Use Data \*

Private Well Domestic  Agricultural \_\_\_\_\_ Industrial \_\_\_\_\_ Monitoring \_\_\_\_\_  
Public Well Community \_\_\_\_\_ Non Community \_\_\_\_\_

\* Abandonment Information \*

Bored or Dig Wells

Casing Removed, Y or N? \_\_\_\_\_  
Y Depth to which casing was removed: \_\_\_\_\_  
Depth and Type of Fill: \_\_\_\_\_  
Source of Fill: \_\_\_\_\_  
Removal Plugs From \_\_\_\_\_ to \_\_\_\_\_ From \_\_\_\_\_ to \_\_\_\_\_

Wells other than Bored Wells

Casing removed, Y or N? \_\_\_\_\_  
Depth to which casing was removed: \_\_\_\_\_  
Applicable, depth(s), and type of gravel/sand fill: \_\_\_\_\_  
Source of gravel or sand: \_\_\_\_\_  
Cement: From \_\_\_\_\_ to \_\_\_\_\_ From \_\_\_\_\_ to \_\_\_\_\_


Method of permanently marking location:

Installed watertight top

Drillers Log

NOT TO SCALE

Depth	Description of Formation or Sediment
0 - 10'	red sandy clay
10' - 30'	TAN sandy clay
30' - 50'	grey sandy clay
50' - 170'	grey / green clay
170' - 200'	brown coarse sand w/ shells

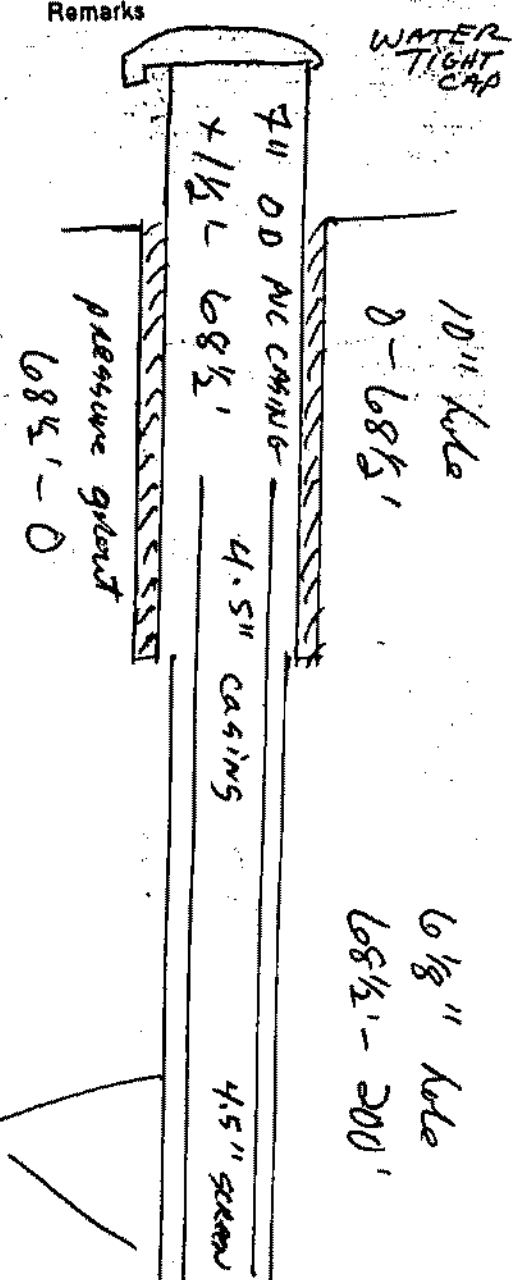

20 GPM  
180'-200'

(Use additional Sheets if necessary)

I hereby certify that the information contained here is true and that this well was installed and constructed in accordance with the permit and that the well complies with all applicable state and local regulations, ordinances and laws.

ARTESIAN WATER WELLS, INC.  
11412 GORDON RD  
BRUCE VA 22407  
540-785-8163

Wade M. Smith  
8/31/01 Representing A 62 W 1

Contractors License Number 2705-046112